


STATE OF KANSAS  
STATE CORPORATION COMMISSION

WELL PLUGGING RECORD

Give All Information Completely  
Make Required Affidavit  
Mail or Deliver Report to:  
Conservation Division  
State Corporation Commission  
212 No. Market  
Wichita, Kansas

Location as "NE/CNW/SW" or footage from lines KIOWA County, Sec. 29 Twp. 30s Rge. 17 (W)  
APP. C SE/4  
Lease Owner PETROLEUM, INC.,  
Lease Name ELWELL UNIT Well No. 1  
Office Address R. R. #2, GREAT BEND, KANSAS  
Character of Well (completed as Oil, Gas or Dry Hole) DRY HOLE  
Date well completed FEBRUARY 4 19 69  
Application for plugging filed FEBRUARY 4 19 69  
Application for plugging approved FEBRUARY 4 19 69  
Plugging commenced FEBRUARY 4 19 69  
Plugging completed FEBRUARY 4 19 69  
Reason for abandonment of well or producing formation NO PRODUCIBLE ZONE

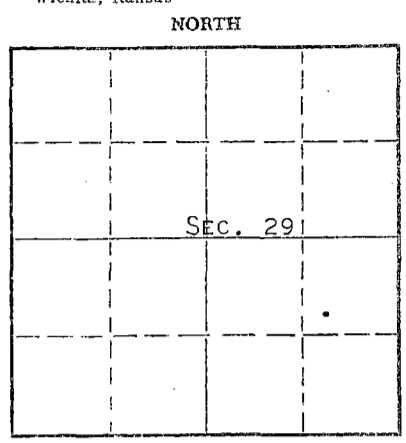

Locate well correctly on above Section Flat

If a producing well is abandoned, date of last production NONE 19  
Was permission obtained from the Conservation Division or its agents before plugging was commenced? YES

Name of Conservation Agent who supervised plugging of this well R. J. WARREN  
Producing formation \_\_\_\_\_ Depth to top \_\_\_\_\_ Bottom \_\_\_\_\_ Total Depth of Well 5080 Feet  
Show depth and thickness of all water, oil and gas formations.

OIL, GAS OR WATER RECORDS

CASING RECORD

FORMATION	CONTENT	FROM	TO	SIZE	PUT IN	PULLED OUT
				8-5/8"	519'	NONE

Describe in detail the manner in which the well was plugged, indicating where the mud fluid was placed and the method or methods used in introducing it into the hole. If cement or other plugs were used, state the character of same and depth placed, from \_\_\_\_\_ feet to \_\_\_\_\_ feet for each plug set.

HEAVY MUD TO 300', FOLLOWED WITH 25 SACKS CEMENT. HEAVY MUD TO 40', FOLLOWED WITH 10 SACKS CEMENT TO BASE OF WELL CELLAR.

RECEIVED  
STATE CORPORATION COMMISSION  
FEB 13 1969  
CONSERVATION DIVISION  
Wichita, Kansas  
2-13-1969

(If additional description is necessary, use BACK of this sheet)  
Name of Plugging Contractor GARVEY DRILLING COMPANY  
Address R. R. #2, GREAT BEND, KANSAS

STATE OF KANSAS, COUNTY OF BARTON, ss.  
MONTE CHADD (employee of owner) or (~~owner or operator~~) of the above-described

well, being first duly sworn on oath, says: That I have knowledge of the facts, statements, and matters herein contained and the log of the above-described well as filed and that the same are true and correct. So help me God. MONTE CHADD, DIST. PROD. SUPT.

(Signature) [Signature]  
P. O. Box 72, GREAT BEND, KANSAS  
(Address)

SUBSCRIBED AND SWORN TO before me this 11 day of FEBRUARY 19 69  
[Signature]  
Notary Public.

# WELL LOG

COMPANY Petroleum, Inc.

SEC. 29 T. 30S R. 17W

FARM Elwell NO. 1

LOC. C SE


TOTAL DEPTH 5080'

COUNTY Kiowa Co., Kansas

COMM. 1-21-69 COMP. 2-4-69

CONTRACTOR Garvey Drilling Company

CASING 8 5/8" @ 519' w/350 sx

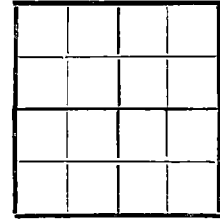

ELEVATION 2164' KB

PRODUCTION D & A

FIGURES INDICATE BOTTOM OF FORMATIONS

- 20' Sand
- 40' Rock
- 280' Clay & Blue Shale
- 340' Red Bed
- 430' Red Bed & Sand
- 490' Lime & Red Bed
- 1000' Red Bed & Shale
- 1375' Shale
- 1830' Shale & Shells
- 2350' Lime & Shale
- 2574' Lime
- 3055' Lime & Shale
- 3140' Lime
- 4439' Lime & Shale
- 4652' Lime
- 4791' Lime & Shale
- 4850' Lime
- 4892' Lime & Shale
- 4952' Lime
- 5059' Lime & Shale
- 5074' Chert & Lime
- 5080' Lime
- 5080' RTD

RECEIVED  
 STATE CORPORATION COMMISSION  
 FEB 13 1969  
 CONSERVATION DIVISION  
 Wichita, Kansas

State of Kansas }  
 County of Barton } ss

I, Eunice McEachern of Garvey Drilling Company  
 upon oath state the above and foregoing is a true and correct copy of the log of the Elwell No. 1 well.

Eunice McEachern

Subscribed and sworn to before me this 5th day of February 1969

My Commission Expires: November 5th, 1969

Richard S. Boep  
 NOTARY PUBLIC