


STATE OF KANSAS
STATE CORPORATION COMMISSION

WELL PLUGGING RECORD

Give All Information Completely
Make Required Affidavit
Mail or Deliver Report to
Conservation Division
State Corporation Comm.
245 North Water
Wichita, KS 67202

Kiowa County, Sec. 30 Twp. 30S Rge. 17W XX/W
Location as "NE/CNW $\frac{1}{4}$ SW $\frac{1}{4}$ " or footage from lines
SW SW SW

Lease Owner Beren Corporation
Lease Name Snyder Well No. 1
Office Address 970 Fourth Financial Center, Wichita, KS
Character of Well (Completed as Oil, Gas or Dry Hole) dry hole

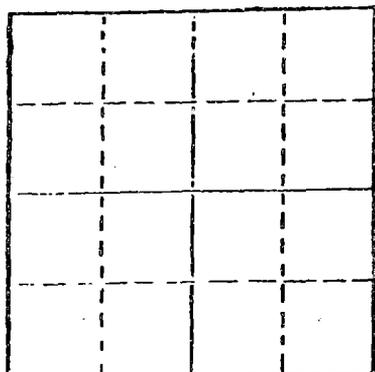

Locate well correctly on above
Section Plat

Date Well completed 5/24/81 19
Application for plugging filed 5/24/81 19
Application for plugging approved 5/24/81 19
Plugging commenced 5/24/81 19
Plugging completed 5/24/81 19
Reason for abandonment of well or producing formation dry hole

If a producing well is abandoned, date of last production 19

Was permission obtained from the Conservation Division or its agents before plugging was commenced? yes

Name of Conservation Agent who supervised plugging of this well M. Leslie
Producing formation _____ Depth to top _____ Bottom _____ Total Depth of Well _____
Show depth and thickness of all water, oil and gas formations.

OIL, GAS OR WATER RECORDS

CASING RECORD

| FORMATION | CONTENT | FROM | TO | SIZE | PUT IN | PULLED OUT |
|-----------|---------|------|----|------|--------|------------|
| | | | | | | |
| | | | | | | |
| | | | | | | |
| | | | | | | |

Describe in detail the manner in which the well was plugged, indicating where the mud fluid was placed and the method or methods used in introducing it into the hold. If cement or other plugs were used, state the character of same and depth placed, from _____ feet to _____ feet for each plug set.

Hole plugged with 60-40 pozmix as follows:
40 sacks @ 550', 10 Sacks at 40', 10 sacks rat hole,
5 sacks mouse hole. Plugging completed at 8:00 PM,
5/24/81.

(If additional description is necessary, use BACK of this sheet)

Name of Plugging Contractor BEREDCO INC.

STATE OF Kansas COUNTY OF Sedgwick, ss.
Jerome D. Marcus (employee of owner) or (owner or operator)
of the above-described well, being first duly sworn on oath, says: That I have knowledge of the facts, statements, and matters herein contained and the log of the above-described well as filed and that the same are true and correct. So help me God.

(Signature)

401 E. Douglas, Suite 402, Wichita, KS 67202
(Address)

SUBSCRIBED AND SWORN TO before me this 9th day of June, 19 81



Marco J. Dearth
Notary Public.

My commission expires 4/27/85

RECEIVED
STATE CORPORATION COMMISSION
JUN 11 1981
6-11-1981
CONSERVATION DIVISION
Wichita, Kansas

CONTRACTOR'S WELL LOG

OPERATOR: Z The Maurice L. Brown Co.
 CONTRACTOR: Abercrombie Drilling, Inc.
 WELL NAME: Waters #1
 LOCATION: C SW Section 30-30S-17W
 Kiowa County, Kansas
 SPUD DATE: December 13, 1977
 COMPLETION DATE: December 30, 1977

| | | |
|------|------|------------------------|
| 0 | 400 | Sand, shale & red beds |
| 400 | 1700 | Shale & shells |
| 1700 | 2131 | Shale & lime |
| 2131 | 2865 | Lime & shale |
| 2865 | 3185 | Shale & lime |
| 3185 | 3352 | Lime & shale |
| 3352 | 3716 | Shale & lime |
| 3716 | 3882 | Lime & shale |
| 3882 | 4110 | Shale & lime |
| 4110 | 4252 | Lime & shale |
| 4252 | 4312 | Shale & lime |
| 4312 | 4538 | Lime & shale |
| 4538 | 4842 | Lime |
| 4842 | 4895 | Lime & shale |
| 4895 | 5107 | Lime |
| | 5107 | Rotary Total Depth |

RECEIVED
 STATE CORPORATION COMMISSION
 JAN 05 1978
 CONSERVATION DIVISION
 Wichita, Kansas

Spud hole at 11:00 a.m., December 13, 1977. Drilled 1116' of 12 1/4" hole. Ran 13 joints of 8-5/8" surface casing. Set at 554'. Cemented with 300 sacks Halliburton lite cement, 3% CaCl followed with 150 sacks Class "A" Cement, 3% CaCl. Plug was down at 4:30 a.m., December 14, 1977.

T. D. 5107'. Set 1st plug at 550' with 40 sacks, 2nd plug at 40' with 12 sacks, 3 sacks in rathole. Cemented with Halliburton Cement. Job complete at 8:30 p.m., December 30, 1977. State Plugger - Bill Owens.


STATE OF KANSAS)
) ss
 COUNTY OF SEDGWICK)

Jack L. Partridge, Assistant Secretary-Treasurer of Abercrombie Drilling, Inc., does hereby state that the above and foregoing is a true and correct copy of the log of the Waters #1, C SW Section 30-30S-17W, Kiowa County, Kansas.

ABERCROMBIE DRILLING, INC.

BY Jack L. Partridge
 Jack L. Partridge
 Assistant Secretary-Treasurer

Subscribed and sworn to before me, a Notary Public, in and for the aforesaid county and state as of this 4th day of January, 1978.

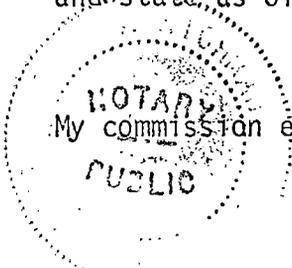

Sandra Richman
 Sandra Richman, Notary Public


STATE OF KANSAS
STATE CORPORATION COMMISSION

WELL PLUGGING RECORD

Give All Information Completely
Make Required Affidavit
Mail or Deliver Report to
Conservation Division
State Corporation Comm.
245 North Water
Wichita, KS 67202

Kiowa County. Sec. 30 Twp. 30S Rge. 17 E/W
Location as "NE/CNW $\frac{1}{4}$ SW $\frac{1}{4}$ " or footage from lines
C SW

Lease Owner The Maurice L. Brown Co.
Lease Name Waters Well No. 1
Office Address 200 Sutton Place Bldg., Wichita, Ks. 67202
Character of Well (Completed as Oil, Gas or Dry Hole) Dry Hole

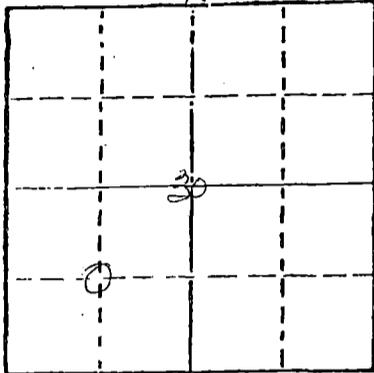

Locate well correctly on above
Section Plot

Date Well completed Dec. 30, 1977
Application for plugging filed (verbally) Dec. 30, 1977
Application for plugging approved (verbally) Dec. 30, 1977
Plugging commenced Dec. 30, 1977
Plugging completed Dec. 30, 1977

Reason for abandonment of well or producing formation
No commercial quantity of oil or gas encountered
If a producing well is abandoned, date of last production
19

Was permission obtained from the Conservation Division or
its agents before plugging was commenced? Yes

Name of Conservation Agent who supervised plugging of this well Bill Owens
Producing formation _____ Depth to top _____ Bottom _____ Total Depth of Well 5107
Show depth and thickness of all water, oil and gas formations.

OIL, GAS OR WATER RECORDS

CASING RECORD

| FORMATION | CONTENT | FROM | TO | SIZE | PUT IN | PULLED OUT |
|-----------|---------|------|----|------|--------|------------|
| | | | | | | |
| | | | | | | |
| | | | | | | |
| | | | | | | |
| | | | | | | |

Describe in detail the manner in which the well was plugged, indicating where the mud fluid was placed and the method or methods used in introducing it into the hold. If cement or other plugs were used, state the character of same and depth placed, from _____ feet to _____ feet for each plug set.

Set 1st plug at 550' with 40 sacks
2nd plug at 40' with 12 sacks
3 sacks in rathole
Cemented with Halliburton Cement
Plug was down at 8:30 p.m., December 30, 1977

RECEIVED
STATE CORPORATION COMMISSION
1-5-1978
JAN 05 1978

CONSERVATION DIVISION
Wichita, Kansas

(If additional description is necessary, use BACK of this sheet)

Name of Plugging Contractor Abercrombie Drilling, Inc.

STATE OF Kansas COUNTY OF Sedgwick, ss.
Jack L. Partridge, Ass't. Secretary-Treasurer (employee of owner) or (owner or operator)
of the above-described well, being first duly sworn on oath, says: That I have knowledge of
the facts, statements, and matters herein contained and the log of the above-described well
as filed and that the same are true and correct. So help me God.

(Signature) Jack L. Partridge
801 Union Center, Wichita, Kansas 67202
(Address)

SUBSCRIBED AND SWORN TO before me this 4th day of January, 1978



Sandra Richman
Sandra Richman, Notary Public.

My commission expires July 21, 1979