


STATE OF KANSAS
STATE CORPORATION COMMISSION
200 Colorado Derby Bldg.
Wichita, Kansas 67202

Form CP-4
Rev. 12-15-80

WELL PLUGGING RECORD

Give All Information Completely
Make Required Affidavit

COUNTY Kiowa SEC. 31 TWP. 30S RGE. 17W 2/W
Location as in quarters or footage from lines:
E/2 NE SE

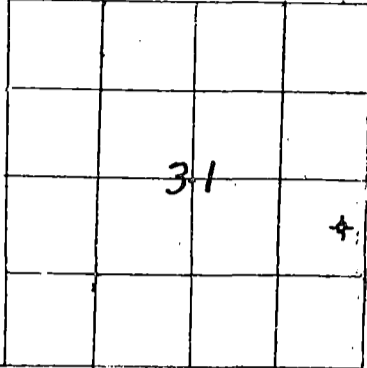

Locate Well
correctly on above
Section Platt.

Lease Owner Banks Oil Company
Lease Name Moberley Well No. 2-31
Office Address 200 W. Douglas, Suite 550, Wichita, KS 67202
Character of Well (Completed as Oil, Gas or Dry Hole): Dry Hole.
Date Well Completed November 22, 1982
Application for plugging filed 12/1/82
Plugging commenced 11/22/82
Plugging completed 11/22/82
Reason for abandonment of well or producing formation Dry Hole

Was permission obtained from the Conservation Division or it's
Agent's before plugging was commenced? Yes

Name of Conservation Agent who supervised plugging of this well Paul Luthi
Producing formation _____ Depth to top _____ bottom _____ T.D. 5115'
Show depth and thickness of all water, oil and gas formations.

OIL, GAS OR WATER RECORDS Casing Record

Formation	Content	From	To	Size	Put in	Pulled Out
		0'	531'	8-5/8"	524'	None

Describe in detail the manner in which the well was plugged, indicating where the mud
fluid was placed and the method or methods used in introducing it into the hold. If cement
or other plugs were used, state the character of same and depth placed, from _____ feet
to _____ feet for each plug set.

Plugged with plug and 50 sacks cement at 900';
plug and 50 sacks cement at 540'; bridge plug
and 10 sacks cement at 40'; circulated cement
in rat hole.

(If additional description is necessary, use BACK of this sheet)

Name of Plugging Contractor Sun Oil Well Cementing Co.


STATE OF KANSAS COUNTY OF SEDGWICK, ss.

John D. Knightley, Agent (employee of owner) or (owner or operator) of the
above-described well, being first duly sworn on oath, says: That I have knowledge of the
facts, statements, and matters herein contained and the log of the above-described well as
filed and that the same are true and correct. So help me God.

(Signature) [Signature]
221 S. Broadway, Wichita, KS 67202
(Address)

SUBSCRIBED AND SWORN TO before me this 1st day of December, 1982

My Commission expires: March 12, 1983

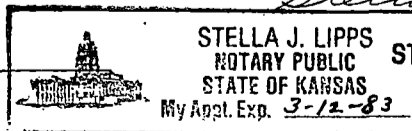

Notary Public
STATE CORPORATION COMMISSION
12-8-1982
DEC 08 1982

CONSERVATION DIVISION
Wichita, Kansas

Banks Oil Company -
200 W. Douglas, Suite 550
Wichita, Kansas 67202

Moberley #2-31
E/2 NE SE Sec. 31-30S-17W
Kiowa County, Kansas

Contractor: D. R. Lauck Oil Company, Inc.
221 S. Broadway, Suite 400
Wichita, Kansas 67202

Commenced: November 12, 1982
Completed: November 22, 1982

Drillers Log

Clay & Shale	145
Sand	220
Shale	275
Sand & Shale, Red Bed	385
Sand & Red Bed	1008
Red Bed	1085
Shale & Clay	1535
Anhydrite	1540
Shale & Sand	1850
Shale	2505
Shale & Shells	2770
Shale	3130
Shale & Shells	3355
Lime & Shale	4360
Lime	5115 RTD

Casing: 531' 8-5/8" cemented with 375 sacks Common Cement,
2% Gel, 3% CaCl₂, 1/4# Flo Seal per sack.

RECEIVED
STATE COOPERATIONAL COMMISSION

DEC 08 1982

CONSERVATION DIVISION
Wichita, Kansas