

STATE OF KANSAS
STATE CORPORATION COMMISSION

WELL PLUGGING RECORD
OR
FORMATION PLUGGING RECORD

Strike out upper line
when reporting plug-
ging off formations.

Give All Information Completely
Make Required Affidavit
Mail or Deliver Report to:
Conservation Division
State Corporation Commission,
800 Bittling Building,
Wichita, Kansas

pd.
10/22/38
ka

McPherson County. Sec. 13 Twp. 19 Rge. (E) 3 (W)

Location as "NE $\frac{1}{4}$ NW $\frac{1}{4}$ SW $\frac{1}{4}$ " or footage from lines SE cor. NW $\frac{1}{4}$ SW $\frac{1}{4}$

Lease Owner The Springrose Drilling Company

Lease Name Tull Well No. 1

Office Address 809 Ellis-Singleton Building, Wichita, Kansas

Character of Well (Completed as Oil, Gas or Dry Hole) Dry hole

Date, well completed October 6, 1938.

Application for plugging filed October 8, 1938.

Application for plugging approved October 8, 1938.


Plugging Commenced October 8, 1938.

Plugging Completed October 11, 1938.

Reason for abandonment of well or producing formation Dry

If a producing well is abandoned, date of last production 193.

Was permission obtained from the Conservation Division or its agents before plugging was com-
menced? Yes

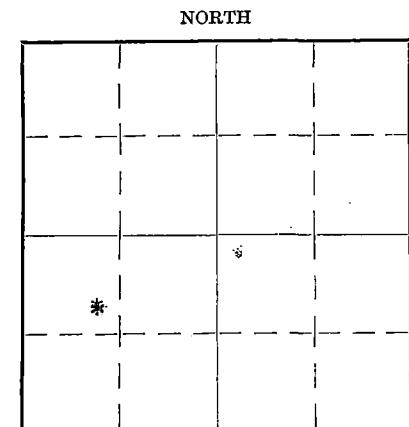

Locate well correctly on above
Section Plat

Name of Conservation Agent who supervised plugging of this well Guy Wiershing

Producing formation Depth to top Bottom Total Depth of Well 3434 Feet

Show depth and thickness of all water, oil and gas formations.

OIL, GAS OR WATER RECORDS

CASING RECORD

Formation	Content	From	To	Size	Put In	Pulled Out
Kansas City Lime	Show oil	2352	2358	10"	120	None
Lime	Show oil	3267	3269	7"	2938	1200
Soft lime	Water	3432	3434			

Describe in detail the manner in which the well was plugged, indicating where the mud fluid was placed and the method or methods used in introducing it into the hole. If cement or other plugs were used, state the character of same and depth placed, from.....feet to.....feet for each plug set.

Hole was filled with cement and chat from 3434' to 2320' above the Kansas City Lime.
Hole was filled with mud from 2320' to 200'. A 15 foot cement plug was set at 200' and hole filled to top with mud. A cap was then welded on top of surface pipe.

pd.
10/22/38
ka
10-22-38 RECEIVED OCT 22 1938

PLUGGING
FILE SEC 13 T 19 R 3 W
BOOK PAGE 37 LINE 43

(If additional description is necessary use BACK of this sheet)

Correspondence regarding this well should be addressed to The Springrose Drilling Company
Address 809 Ellis-Singleton Building, Wichita, Kansas.

STATE OF Kansas, COUNTY OF Sedgwick, ss.

W. Beardmore (employee of owner) or (owner or operator) of the above-described well,
being first duly sworn on oath, says: That I have knowledge of the facts, statements, and matters herein contained and the log of the above-described well as filed and that the same are true and correct. So help me God.

(Signature) *W. M. Beardmore*

809 Ellis-Singleton Bldg. Wichita, Kansas.
(Address)

SUBSCRIBED AND SWORN to before me this 20th day of October, 1938.

My commission expires July 31, 1941

St. J. Heider
Notary Public.

Tull #1 Well

SE 1/4 NW 1/4 SW 1/4 Sec 13-19-3W
McPherson County, Kansas

Drilled by: The Springrose Drilling Company

Casing Record:

12 3/8" 122'
7" od 2938'
5 3/16" 3219' 8"

Drilling Commenced: August 15, 1938
Drilling Completed: September 24, 1938

<u>FORMATION</u>	<u>DEPTH</u>
red bed, clay	122
shale & lime	425
brk. lime & lime	565
lime & shale	685
brk. lime	820
lime	1145
lime & shale	1400
shale & shells	1465
shale	1570
shale & shells	1815
lime	1960
hard lime	2000
lime	2100
brk. lime	2115
lime	2130
shale	2250
lime	2290
sandy	2300
lime	2305
shale, lime shells	2352
soft lime--show of oil	2358
lime	2365
hard lime	2435
lime	2640
lime & shale	2675
shale	2795
shale & shells	2830
shale	2918
chat	2952
lime	2961
lime & chat	2975
white chat	2987
blue shale	3025
shale	3125
blue shale	3153
shale	3195
dark shale	3212
sandy shale	3217
shale	3230
brk. lime & sandy shale	3253
shale	3262
dark shale	3267
lime--show of oil	3269
brk. lime	3274
Viola lime	3302
sandy shale & lime	3334
brk. lime	3360
lime, white & brown, brk.	3397
brown lime	3400
white, hard lime	3414
hard lime	3432
soft lime	3434
TOTAL DEPTH	D. & A.

