

WELL PLUGGING RECORD

Give All Information Completely
Make Required Affidavit
Mail or Deliver Report to:
Conservation Division
State Corporation Commission
211 No. Broadway
Wichita, Kansas

Pawnee County. Sec. 15 Twp. 20S Rge. 16 (E) W (W)

Location as "NE/CNW/SW" or footage from lines NE/4 NE/4 SW/4

Lease Owner Birmingham-Bartlett Drilling Co.

Lease Name ALMQUIST "B"

Well No. 1

Office Address 300 Kaufman Building, Wichita, Kansas 67202

Character of Well (completed as Oil, Gas or Dry Hole) Dry Hole

Date well completed November 1, 19 64

Application for plugging filed (verbal) November 1, 19 64

Application for plugging approved (verbal) November 1, 19 64


Plugging commenced November 1, 19 64

Plugging completed November 1, 19 64

Reason for abandonment of well or producing formation Dry Hole

If a producing well is abandoned, date of last production 19

Was permission obtained from the Conservation Division or its agents before plugging was commenced? Yes

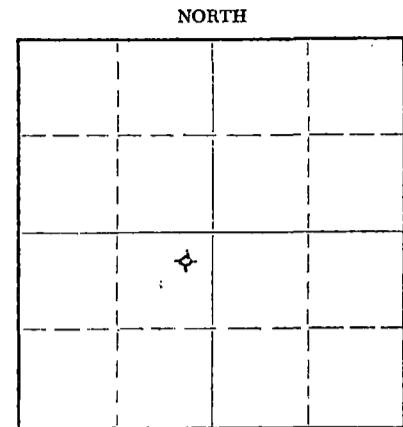

Locate well correctly on above Section Plat

Name of Conservation Agent who supervised plugging of this well Eldon Petty

Producing formation Depth to top Bottom Total Depth of Well 3826 Feet

Show depth and thickness of all water, oil and gas formations.

OIL, GAS OR WATER RECORDS

CASING RECORD

FORMATION	CONTENT	FROM	TO	SIZE	PUT IN	PULLED OUT
		0	276'	8-5/8"	276'	None

Describe in detail the manner in which the well was plugged, indicating where the mud fluid was placed and the method or methods used in introducing it into the hole. If cement or other plugs were used, state the character of same and depth placed, from feet to feet for each plug set.

Bottom plug set at 350' with 20 sacks cement mixed and poured through drill pipe. Middle plug set at 200' with 20 sacks. Top plug set at 40' with 10 sacks.

RECEIVED
STATE CORPORATION COMMISSION

NOV 4 1964

11-4-64

CONSERVATION DIVISION
Wichita, Kansas

(If additional description is necessary, use BACK of this sheet)

Name of Plugging Contractor Birmingham-Bartlett Drilling Co.

Address 300 Kaufman Building, Wichita, Kansas 67202

STATE OF KANSAS, COUNTY OF SEDGWICK
Richard Hindery, partner of Birmingham-Bartlett Drilling Co., owner, operator and contractor (employee of owner) or (owner or operator) of the above-described well, being first duly sworn on oath, says: That I have knowledge of the facts, statements, and matters herein contained and the log of the above-described well as filed and that the same are true and correct. So help me God. BIRMINGHAM-BARTLETT DRILLING CO.

(Signature) By Richard Hindery Partner
300 Kaufman Building, Wichita, Kansas 67202
(Address)

SUBSCRIBED AND SWORN TO before me this 3rd day of November, 19 64

My commission expires October 2, 1966.

Beverly Larson
Beverly Larson Notary Public.

ALMQUIST "B" NO. 1

LOCATION: NE/4 NE/4 SW/4
Section 15-20S-16W
Pawnee County, Kansas

SPUDED: 10-24-64
DRILLING
COMPLETED: 11-1-64

OWNER, OPERATOR
and CONTRACTOR: Birmingham-Bartlett Drilling Co.
300 Kaufman Building
Wichita, Kansas 67202

SURFACE CASING: 8-5/8" casing cemented at
276' with 200 sacks cement.

OIL STRING: None set. Dry hole.
Plugged 11-1-64.

LOG

(Figures indicate bottom of formation)

0 - 40	Surface clay
277	Shale, shells and sand
450	Shale and shells
615	Sand
1040	Red bed
1075	Red bed and shale
1108	Anhydrite
1975	Shale and shells
3250	Shale and lime
3352	Lime
3504	Shale and lime
3631	Lime
3677	Shale and lime
3826	Lime
3826	Rotary total depth

RECEIVED
STATE CORPORATION COMMISSION

NOV 4 1964

CONSERVATION DIVISION
Wichita, Kansas

The undersigned, Richard Hindery, one of the partners of Birmingham-Bartlett Drilling Co., hereby certifies that the above is a true and correct log of the Almquist "B" No. 1 Well as shown in the daily drilling reports.

BIRMINGHAM-BARTLETT DRILLING CO.

By Richard Hindery
Richard Hindery, Partner

Subscribed and sworn to before me
this 3rd day of November, 1964.

Beverly Larson
Beverly Larson, Notary Public

My commission expires October 2, 1966.