

STATE OF KANSAS CORPORATION COMMISSION

WELL PLUGGING RECORD


Give All Information Completely Make Required Affidavit Mail or Deliver Report to: Conservation Division State Corporation Commission 800 Blitting Building Wichita, Kansas

OR

FORMATION PLUGGING RECORD

Strike out upper line when reporting plugging of formations.

Pawnee County Sec 13 Twp 20S Rge 16 (E) W (W) Location as NE1/4NW1/4SW1/4 or footage from lines E2, NW1/4, SW1/4 Lease Owner Stanolind Oil and Gas Company Lease Name Nellie Belt Well No 3 Office Address P. O. Box 1654, Oklahoma City, Oklahoma Character of Well (completed as Oil, Gas or Dry Hole) Oil Date well completed 1-25 19 47 Application for plugging filed 1-30 19 48 Application for plugging approved 1-31 19 48 Plugging commenced 2-24 19 48 Plugging completed 3-18 19 48 Reason for abandonment of well or producing formation Uneconomical to operate If a producing well is abandoned, date of last production 3-21 19 47 Was permission obtained from the Conservation Division or its agents before plugging was commenced? Yes

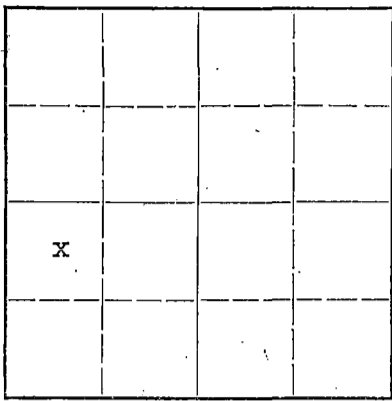

Locate well correctly on above Section Plat

Name of Conservation Agent who supervised plugging of this well H. W. Kerr Producing formation Arbuckle Depth to top 3801 Bottom 3867 Total Depth of Well 3867 Feet Show depth and thickness of all water, oil and gas formations.

OIL, GAS OR WATER RECORDS

CASING RECORD

Table with 7 columns: Formation, Content, From, To, Size, Put In, Pulled Out. Row 1: Arbuckle, 3801, 3867, 8-5/8" OD, 657, None. Row 2: 5-1/2" OD, 3866, 2730.

Describe in detail the manner in which the well was plugged, indicating where the mud fluid was placed and the method or methods used in introducing it into the hold. If cement or other plugs were used, state the character of same and depth placed, from feet to feet for each plug set.

Plugged w/crushed rock 3860-3840 Topped w/5 sax cement 3840-3800 Heavy Mud 3800-600 15 sax cement 600 - 480 Heavy mud 480 - 200 10 sax cement 200 - 120 Heavy Mud 120 - 80 10 sax cement Cap 80 - 4 Surface pipe cut 4' below ground level.

(If additional description is necessary, use BACK of this sheet)

Correspondence regarding this well should be addressed to T. L. Regan Address Box, 1654, Oklahoma City, Oklahoma


STATE OF Kansas, COUNTY OF Barton, ss. H. G. Nething (employee of owner) or (owner or operator) of the above-described well, being first duly sworn on oath, says: That I have knowledge of the facts, statements, and matters herein contained and the log of the above-described well as filed and that the same are true and correct. So help me God.

(Signature) H.G. Nething Field Supt.

Box 8, Ellinwood, Kansas (Address)

SUBSCRIBED AND SWORN to before me this 26th day of March 1948 Notary Public. W.G. Cox 3-30-48

My commission expires October 18, 1950

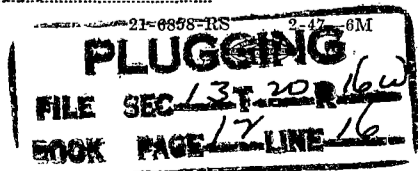



FORMATION RECORD

DESCRIBE EACH FORMATION DRILLED. INDICATE THICKNESS, CONTENT AND WHETHER DRY, OR OIL, GAS, OR WATER BEARING.

FORMATION	TOP	BOTTOM	FORMATION	TOP	BOTTOM
Cellar	0	10			
Shale - clay	10	102			
Sticky Clay	102	170			
Sand	170	190			
Shale - sand	190	284			
Sticky blue shale	284	366			
Sand	366	425			
Blue shale	425	480			
Sand & hard shells	480	642			
Red beds	642	1110			
Anhydrite	1110	1140			
Shale - Shells	1140	1630			
Salt	1630	1670			
Salt - Shell	1670	1700			
Shale - Shells	1700	3280			
Lime	3280	3500			
Shale	3500	3538			
Lime	3538	3625			
Broken Lime	3625	3645			
Lime	3645	3793			
Shale	3793	3801			
Top Arbuckle	3801				
Dolomite	3801	3867			
Total Depth		3867			
Plug Back		3863			