


STATE OF KANSAS
STATE CORPORATION COMMISSION

Give All Information Completely
Make Required Affidavit
Mail or Deliver Report to:
Conservation Division
State Corporation Commission
800 Biting Building
Wichita, Kansas

WELL PLUGGING RECORD

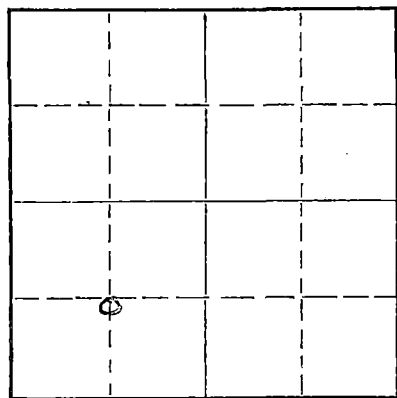

Locate well correctly on above
Section Plat

Stanton County, Sec. 13 Twp. 30S Rge. (E) 41 (W)
Location as "NE/CNW/SW" or footage from lines 1320' E of W Line; 1250' N of S Line
Lease Owner Falcon Seaboard Drilling Company
Lease Name Beauchamp Well No. 1
Office Address Pan American Building, Tulsa, Oklahoma
Character of Well (completed as Oil, Gas or Dry Hole) Dry Hole
Date well completed April 29, 1961
Application for plugging filed April 28, 1961
Application for plugging approved April 28, 1961
Plugging commenced April 29, 1961
Plugging completed April 29, 1961
Reason for abandonment of well or producing formation

If a producing well is abandoned, date of last production 19
Was permission obtained from the Conservation Division or its agents before plugging was commenced? Yes

Name of Conservation Agent who supervised plugging of this well W. L. Lac Kamp, Jr.
Producing formation Depth to top Bottom Total Depth of Well 5604 Feet
Show depth and thickness of all water, oil and gas formations.

OIL, GAS OR WATER RECORDS

CASING RECORD

FORMATION	CONTENT	FROM	TO	SIZE	PUT IN	PULLED OUT
				8-5/8"	1607	None

Describe in detail the manner in which the well was plugged, indicating where the mud fluid was placed and the method or methods used in introducing it into the hole. If cement or other plugs were used, state the character of same and depth placed, from feet to feet for each plug set.

Set 20 sack cement plug @ 1600'
Set 20 sack cement plug @ 625'
Set 10 sack cement plug @ 40'
Welded steel cap on top of 8-5/8" casing.

RECEIVED
STATE CORPORATION COMMISSION
MAY 31 1961
CONSERVATION DIVISION
Wichita, Kansas

5-31-61

Name of Plugging Contractor Graham-Michaelis Drilling Company
Address Liberal, Kansas

STATE OF OKLAHOMA, COUNTY OF TULSA, ss.
J.O. Brown (employee of owner) or (owner or operator) of the above-described well, being first duly sworn on oath, says: That I have knowledge of the facts, statements, and matters herein contained and the log of the above-described well as filed and that the same are true and correct. So help me God.

(Signature) J.O. Brown
805 Pan American Building, Tulsa, Oklahoma
(Address)

SUBSCRIBED AND SWORN to before me this 26th day of May, 1961
Ralphue Sanchez
Notary Public.

My commission expires April 6, 1963



BEAUCHAMP #1

WELL RECORD:

LOCATION:

Section 13-308-41W
Stanton County, Kansas

Commenced: 4/10/61
Completed: 4/29/61
(Rotary)

CONTRACTOR:

Graham-Michaelis Drilling Co.
Liberal Division
P. O. Box 896
Liberal, Kansas

CASING RECORD:

49 Jts. 8 5/8" Casing Cemented
w/550 sx Pozmix 4% Gel 1/4# Flo
Seal and 150 sx 60-40 Poz 2% cc

	<u>LOG</u>	
Surface Shale	0 -	200
Sand & Clay	200 -	500
Red Bed & Gyp	500 -	1020
Shale & Lime Shells	1020 -	1330
Shale, Shells & Anhy	1330 -	1605
Sand & Shale	1605 -	1990
Red Bed & Shale	1990 -	2290
Lime & Shale	2290 -	2396
Shale	2396 -	2554
Shale & Lime	2554 -	3553
Lime	3553 -	3619
Lime & Chalky Streaks	3619 -	3736
Lime	3736 -	3812
Lime & Chalk	3812 -	4145
Lime	4145 -	4323
Lime & Shale	4323 -	4398
Lime	4398 -	4667
Lime & Shale	4667 -	4985
Shale	4985 -	5285
Sand & Shale	5285 -	5345
Shale & Lime	5345 -	5429
Lime	5429 -	5604

5604' - Total Rotary Depth

The undersigned, Graham-Michaelis Drilling Company, Liberal Division, certifies that the above log is a true and correct copy of the formations encountered in drilling the above mentioned well, as taken from the Daily Drilling Report.

GRAHAM-MICHAELIS DRILLING COMPANY
LIBERAL DIVISION

By H. R. Michaelis
H. R. Michaelis

RECEIVED
STATE CORPORATION COMMISSION
MAY 3 1 1961
CONSERVATION DIVISION
Wichita, Kansas