

STATE OF KANSAS
STATE CORPORATION COMMISSION


Form CP-4

Give All Information Completely
Make Required Affidavit
Mail or Deliver Report to:
Conservation Division
State Corporation Commission
212 No. Market
Wichita, Kansas

WELL PLUGGING RECORD

Stanton County, Sec. 3 Twp. 30S Rge. 41 (W)

Location as "NE/CNW/SW" or footage from lines C SW NW
Lease Owner Albert E. Lukken
Lease Name Harmon Well No. 1
Office Address 161 South Belmont, Wichita, Kansas
Character of Well (completed as Oil, Gas or Dry Hole) Dry Hole
Date well completed May 25 19 66
Application for plugging filed May 24 19 66
Application for plugging approved May 24 19 66
Plugging commenced May 24 19 66
Plugging completed May 25 19 66
Reason for abandonment of well or producing formation No Producing Zone

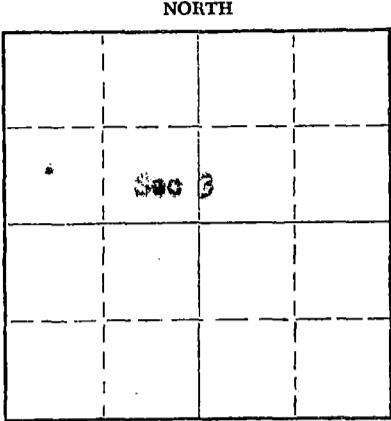

Locate well correctly on above Section Plat

If a producing well is abandoned, date of last production None 19
Was permission obtained from the Conservation Division or its agents before plugging was commenced? Yes

Name of Conservation Agent who supervised plugging of this well Edgar Eves
Producing formation _____ Depth to top _____ Bottom _____ Total Depth of Well 5604 Feet
Show depth and thickness of all water, oil and gas formations.

OIL, GAS OR WATER RECORDS

CASING RECORD

FORMATION	CONTENT	FROM	TO	SIZE	PUT IN	PULLED OUT
				<u>8 5/8"</u>	<u>1552'</u>	<u>None</u>

Describe in detail the manner in which the well was plugged, indicating where the mud fluid was placed and the method or methods used in introducing it into the hole. If cement or other plugs were used, state the character of same and depth placed, from _____ feet to _____ feet for each plug set.
Mudded up with heavy mud to 5150', followed by wooden plug and spotted 50 sacks cement through drill pipe with pump truck. Mudded up with heavy mud to 1600', followed by wooden plug and spotted 35 sacks cement through drill pipe with pump truck. Mudded up with heavy mud to 30', followed by wooden plug and 10 sacks cement on top of plug to base of well collar.

RECEIVED 8-2-66
STATE CORPORATION COMMISSION
AUG 2 1966
CONSERVATION DIVISION
WICHITA, KANSAS

Name of Plugging Contractor Garvey Drilling Company (If additional description is necessary, use BACK of this sheet)
Address Route 2, Great Bend, Kansas

STATE OF Kansas COUNTY OF Barton
Vernie A. Morris (employee of owner) or owner or operator of the above-described

well, being first duly sworn on oath, says: That I have knowledge of the facts, statements, and matters herein contained and the log of the above-described well as filed and that the same are true and correct. So help me God.

(Signature) Vernie A. Morris
Rt 2, Great Bend, Mo. (Address) 66

SUBSCRIBED AND SWORN TO before me this 31st day of May, 1966
November 5, 1969
My commission expires _____
Richard Stoy Notary Public.

WELL LOG

COMPANY Albert E. Lukken

SEC. 3 T. 30S R. 41W

FARM Harmon

NO. 1

LOC. C SW NW


TOTAL DEPTH 5604'

COUNTY Stanton

COMM. 5-6-66

COMP. 5-25-66

CONTRACTOR Garvey Drilling Company

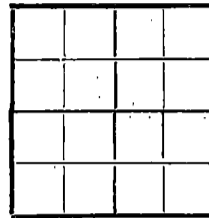

CASING 8 5/8" @ 1552' w/700 sx

ELEVATION 3389' KB

PRODUCTION D & A

FIGURES INDICATE BOTTOM OF FORMATIONS

- 15' Surface Sand and Clay
- 530' Sand and Clay
- 736' Gyp and Red Bed
- 1100' Red Bed and Gyp
- 1274' Red Bed, Gyp and Anhydrite
- 1552' Red Bed and Clay
- 1933' Anhydrite and Red Bed
- 2219' Shale and Shells
- 2483' Shale and Lime
- 4446' Lime and Shale
- 4513' Lime, (Little Chert) and Shale
- 5005' Lime and Shale
- 5130' Lime, Sand and Shale
- 5604' Lime and Shale
- 5604' RTD

RECEIVED
STATE CORPORATION COMMISSION

AUG 2 1966

CONSERVATION DIVISION

State of Kansas }
County of Barton } ss

I, Sam N. Stephens of Garvey Drilling Company

upon oath state the above and foregoing is a true and correct copy of the log of the Harmon No. 1 well.

Sam N. Stephens

Subscribed and sworn to before me this 26th day of May 19 66

My Commission Expires: November 5, 1969

Richard D. Day
NOTARY PUBLIC