


STATE OF KANSAS  
STATE CORPORATION COMMISSION

Give All Information Completely  
Make Required Affidavit  
Mail or Deliver Report to:  
Conservation Division  
State Corporation Commission  
800 Bixby Building  
Wichita, Kansas

WELL PLUGGING RECORD

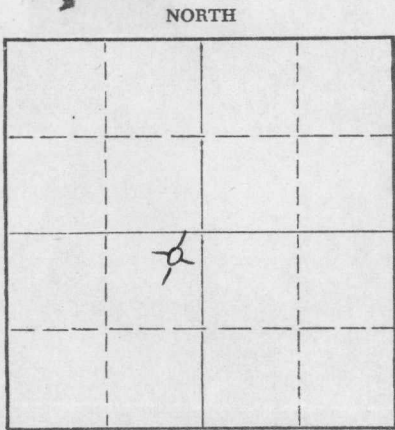

Locate well correctly on above  
Section Plat

Mc Pherson County, Sec. 3 Twp. 19S Rge. 2 (#) (W)

Location as "NE/CNW/SW" or footage from lines NE NE SW

Lease Owner Mallard Drilling Company--Pack Oil Company

Lease Name Nelson Well No. 1

Office Address 1016 Union National Bank Bldg.

Character of Well (completed as Oil, Gas or Dry Hole) Dry

Date well completed December 8 19 54

Application for plugging filed " 19 "

Application for plugging approved " 19 "

Plugging commenced December 23 19 "

Plugging completed December 29 19 "

Reason for abandonment of well or producing formation

If a producing well is abandoned, date of last production 19

Was permission obtained from the Conservation Division or its agents before plugging was commenced? yes

Name of Conservation Agent who supervised plugging of this well Ruel Durkee

Producing formation Depth to top Bottom Total Depth of Well 2971 Feet

Show depth and thickness of all water, oil and gas formations.

OIL, GAS OR WATER RECORDS

CASING RECORD

FORMATION	CONTENT	FROM	TO	SIZE	PUT IN	PULLED OUT
				8 5/8"	155	none
				5 1/2"	2953	2652

Describe in detail the manner in which the well was plugged, indicating where the mud fluid was placed and the method or methods used in introducing it into the hole. If cement or other plugs were used, state the character of same and depth placed, from feet to feet for each plug set.

Filled hole with sand from 2971' to 2945' and ran 6 sacks of cement. Mudded hole to 150' set a 10' rock bridge and ran 15 sacks of cement at 140'. Mudded hole to top and ran 5 sacks of cement. Plugging completed

(If additional description is necessary, use BACK of this sheet)

Name of Plugging Contractor West Supply Company  
Address Chase, Kansas

STATE OF Kansas, COUNTY OF Sedgwick, ss.  
C. C. Nelson, partner Mallard Drg. Co. (employee of owner) or (owner or operator) of the above-described well, being first duly sworn on oath, says: That I have knowledge of the facts, statements, and matters herein contained and the log of the above-described well as filed and that the same are true and correct. So help me God.

(Signature) C. C. Nelson

11 1016 Union National Bank Bldg.  
(Address)

SUBSCRIBED AND SWORN TO before me this 6th day of Jan 19 55

My commission expires 12/4/56

Notary Public. [Signature]

PLUGGING  
FILE SEC 3 T 19 R 2W  
BOOK PAGE 86 LINE 26

RECEIVED  
STATE CORPORATION COMMISSION  
JAN 11 1955  
CONSERVATION DIVISION  
Wichita, Kansas

COMPANY: Pack Oil Company--Mallard Drilling Company  
 CONTRACTOR: Mallard Drilling Company  
 FARM: Nelson #1  
 LOCATION: NE NE SW Sec. 3-19S-2W  
 Mc Pherson County, Kansas  
 COMMENCED: December 1, 1954  
 COMPLETED: December 8, 1954

0	to	155	Surface sand
155	to	220	Shale
220	to	545	Lime
545	to	795	Lime and sand
795	to	1025	Lime and shale
1025	to	1420	Lime and shale
1420	to	1955	Lime and shale
1955	to	2240	Lime, shale and sand
2240	to	2334	Lime and shale
2334	to	2575	Lime
2575	to	2611	Lime and shale
2611	to	2785	Lime and shale
2785	to	2944	Lime and shale
2944	to	2951	Mississippi
2951	to	2956	Lime and chert--T.D. Rotary
2956	to	2960	Chat, show of oil and water
2960	to	2971	Chat, no show
		2971	T.D. Cardwell

Set 155 feet of 8 5/8" surface pipe. Cemented with 100 sacks cement.

Set 5 1/2" at 2953. Cemented with 50 sacks cement.

TOPS: H.C. -- 2334      Mississippi -- 2944  
 Measurements taken from F.D.B.    R.D.B. 5 1/2 ft. from ground level.  
 ELEVATION-- 1563

~~654 2945~~  
~~1584 150~~  
~~5 1/2" Log~~

Hydrafrac from 2953 to 2960 with 1000 gallons jell acid and 1000 pounds sand.  
 DRY AND ABANDONED      Swab 10 barrels of water per hour and show oil.

C E R T I F I C A T E

I, C. C. Nelson, do hereby certify that the above and foregoing is a true and correct copy of log of the Nelson #1, Mc Pherson County, Kansas as reflected by files of the Mallard Drilling Company.

*C. C. Nelson*

Subscribed and sworn to before me a Notary Public, within and for Sedgewick County Kansas, this 14th day of December 1954.

*Harold Wright*

My commission expires 12/4/56

**PLUGGING**  
 FILE SEC 3 T 19 R 2W  
 BOOK 86 LINE 26

RECEIVED  
STATE COMMISSION

CONSULTING