

STATE OF KANSAS
STATE CORPORATION COMMISSION

WELL PLUGGING RECORD

Give All Information Completely
Make Required Affidavit
Mail or Deliver Report to
Conservation Division
State Corporation Comm.
245 North Water
Wichita, KS 67202

McPherson County. Sec. 24 Twp. 19 Rge. 1 E/W
Location as "NE/CNW $\frac{1}{4}$ SW $\frac{1}{4}$ " or footage from lines _____

Lease Owner W & NE Suda
Lease Name Radell Kocher Well No. 2


Office Address Box 89 Malva, KS
Character of Well (Completed as Oil, Gas or Dry Hole) _____

Date Well completed 6-24- 1979
Application for plugging filed 7-18- 1979
Application for plugging approved _____ 19____
Plugging commenced 8-6- 1979
Plugging completed 8-14- 1979
Reason for abandonment of well or producing formation _____

If a producing well is abandoned, date of last production _____ 19____

Was permission obtained from the Conservation Division or its agents before plugging was commenced? yes

Name of Conservation Agent who supervised plugging of this well Wilbert Tanner
Producing formation _____ Depth to top _____ Bottom _____ Total Depth of Well 2980
Show depth and thickness of all water, oil and gas formations.

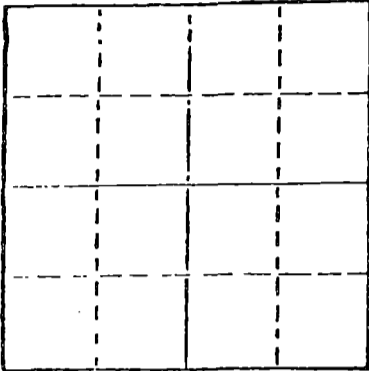

Locate well correctly on above Section Plot

OIL, GAS OR WATER RECORDS

CASING RECORD

FORMATION	CONTENT	FROM	TO	SIZE	PUT IN	PULLED OUT
				5 in		8002.35

Describe in detail the manner in which the well was plugged, indicating where the mud fluid was placed and the method or methods used in introducing it into the hold. If cement or other plugs were used, state the character of same and depth placed, from _____ feet to _____ feet for each plug set. Sand back to 2950'. Put in five sets of cement. Muddled hole to 245'. Made 15 inch string and filled with ready mix.

STATE RECEIVED
CORPORATION COMMISSION

AUG 20 1979

(If additional description is necessary, use BACK of this sheet)

Name of Plugging Contractor Mark Hunt Casing 4-20-79

STATE OF Kansas COUNTY OF McPherson, ss.
Mark Hunt (employee of owner) or (owner or operator)
of the above-described well, being first duly sworn on oath, says: That I have knowledge of the facts, statements, and matters herein contained and the log of the above-described well as filed and that the same are true and correct. So help me God.

(Signature) Mark Hunt
2400 N. Main, Malva, KS.
(Address)

SUBSCRIBED AND SWORN TO before me this 15th day of August, 1979

Everette Hayes
Notary Public.

My commission expires Feb 11, 1980

EVERETTE F. HAYES
NOTARY PUBLIC
RENO COUNTY, KANSAS

well to be plugged

15.113.20558.00.00

DRILLERS WELL LOG

L. D. DRILLING COMPANY - CONTRACTOR

RADELL KOEHN - OPERATOR

DOANE # 2
W/2 NE SW/4 24-19-1
McPHERSON COUNTY, KANSAS

COMMENCED: 6-19-78
COMPLETED: 6-24-78

Casing:

8-5/8" set at 169'
5-1/2" set at 2979' (1' off bottom)

Cement:

W/100 sx. 60/40 Pozmix, 2% Gel, 3% CC
W/75 sx common cement

FORMATION

Shale
Lime & Shale
Miss.

DEPTH

0 - 450
450 - 2909
2909 - 2980

TOPS

Lansing
Miss.

2319
2909

RECEIVED
STATE CORPORATION COMMISSION

JUL 19 1979

CONSERVATION DIVISION
Wichita, Kansas

AFFIDAVIT

State of Kansas County of Barton

I, Wayne of the L. D. DRILLING COMPANY

being first duly sworn on oath, State: That I have knowledge of the facts statements and matters herein contained and that the same are true and correct..

Wayne Dobbs
Wayne Dobbs

Subscribed and sworn to before me on this 27th day of June 1978

My commission expires: 5-20-81

Bessie M. DeWerff
Notary Public: Bessie M. DeWerff

BESSIE M. DEWERFF
STATE NOTARY PUBLIC
BARTON COUNTY, KANSAS
MY APPT. EXP. 5-20-81