


STATE OF KANSAS
STATE CORPORATION COMMISSION

WELL PLUGGING RECORD

Give All Information Completely
Make Required Affidavit
Mail or Deliver Report to
Conservation Division
State Corporation Comm.
245 North Water
Wichita, KS 67202

McPherson County. Sec. 24 Twp. 19 Rge. I W E/W
Location as "NE/CNW1SW1" or footage from lines
330' ENL & 140' WEL S E/4

Lease Owner Decker Petroleum Inc.
Lease Name Nigg Well No. I
Office Address BX 352 Canton, Kansas 67428
Character of Well (Completed as Oil, Gas or Dry Hole) oil

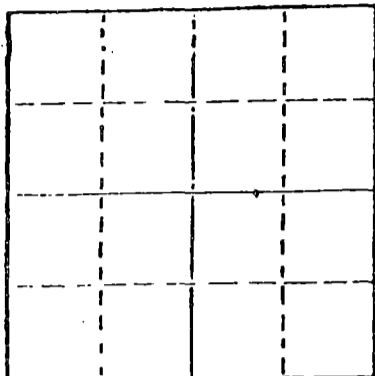

Locate well correctly on above
Section Plat

Date Well completed 5-25 1978
Application for plugging filed 9-6 1978
Application for plugging approved 9-~~##~~ 7 1978
Plugging commenced 9-6 1978
Plugging completed 10-13 1978
Reason for abandonment of well or producing formation _____

If a producing well is abandoned, date of last production _____ 19____

Was permission obtained from the Conservation Division or its agents before plugging was commenced? yes

Name of Conservation Agent who supervised plugging of this well Gilbert Toman
Producing formation _____ Depth to top _____ Bottom _____ Total Depth of Well 2990'
Show depth and thickness of all water, oil and gas formations.

OIL, GAS OR WATER RECORDS

CASING RECORD

FORMATION	CONTENT	FROM	TO	SIZE	PUT IN	PULLED OUT
				<u>4 1/2"</u>		<u>900'</u>

Describe in detail the manner in which the well was plugged, indicating where the mud fluid was placed and the method or methods used in introducing it into the hold. If cement or other plugs were used, state the character of same and depth placed, from _____ feet to _____ feet for each plug set. Plugged off bottom of hole with sand. Sand from 2990' to 2900'. Dumped 5 sx cement. Mudded hole 180'. Made 10' of rock bridge. Dumped 25 sx of cement. Mudded hole to 40'. Made 10' of rock bridge. Dumped 10 sx of cement, filling to the bottom of the cellar.

RECEIVED
STATE CORPORATION COMMISSION

OCT 16 1978 10-16-78

CONSERVATION DIVISION
Wichita, Kansas

(If additional description is necessary, use BACK of this sheet)

Name of Plugging Contractor Art Lamb Casing Pulling Inc.
2809 King St. Hutchinson, Kansas 67501

STATE OF Kansas COUNTY OF Reno, ss.
Art Lamb (employee of owner) or (owner or operator)
of the above-described well, being first duly sworn on oath, says: That I have knowledge of the facts, statements, and matters herein contained and the log of the above-described well as filed and that the same are true and correct. So help me God.

(Signature) Art Lamb
2809 King St. Hutchinson, Kansas 67501
(Address)

SUBSCRIBED AND SWORN TO before me this 13 day of October, 1978

Judy Lamb
Notary Public.

My commission expires April 18, 1982

LOG OF WELL

Nigs #1
330' S of N, Line &
1140' W of E, Line
SE/4 of Section 24-19-1W
McPherson County, Ks.

OPERATOR: Decker Petroleum Inc.

CONTRACTOR: Berentz Drilling Company

Commenced with rotary: 5-21-78

Completed with rotary: 5-25-78

Casing: 8 5/8"---146' cemented with 125 sacks
4 1/2"---2989' " " 75 "

Soil	3
Shale & Shells	358
Shale	420
Lime & Shale	570
Lime	680
Lime & Shale	800
Shale & Lime	1660
Lime	1941
Lime & Shale	2098
Sand Douglas	2180
Shale & Lime	2250
Lime & Shale	2314
Lime Lansing	2756
Shale & Conglomerte	2908
Lime Miss.	2990 R.T.D.

RECEIVED
STATE CORPORATION COMMISSION
SEP 07 1978
CONSERVATION DIVISION
Wichita, Kansas