


STATE OF KANSAS  
STATE CORPORATION COMMISSION

WELL PLUGGING RECORD

Give All Information Completely  
Make Required Affidavit  
Mail or Deliver Report to:  
Conservation Division  
State Corporation Commission  
800 Biting Building  
Wichita, Kansas

McPherson County, Sec. 24 Twp. 19 Rge. 1 (E) (W)

Location as "NE/CNW/SW" or footage from lines C, NE SW NW  
Lease Owner Mundy & Shepard et al  
Lease Name Leffler Well No. 1  
Office Address 321 W. 21st. St. Fremont, Nebraska  
Character of Well (completed as Oil, Gas or Dry Hole) Dry hole  
Date well completed 1-31-56 19  
Application for plugging filed 1-30-56 19  
Application for plugging approved 1-30-56 19  
Plugging commenced 4 AM 1-31-56 19  
Plugging completed 7 AM 1-31-56 19  
Reason for abandonment of well or producing formation Non productive

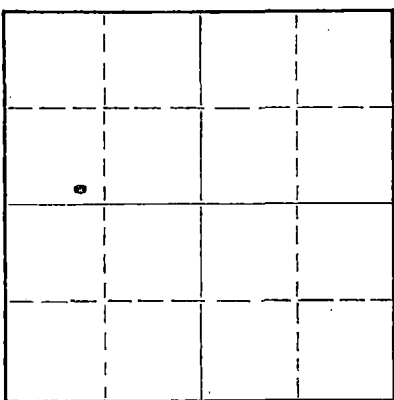

Locate well correctly on above Section Plat

If a producing well is abandoned, date of last production 19  
Was permission obtained from the Conservation Division or its agents before plugging was commenced? Yes

Name of Conservation Agent who supervised plugging of this well Ruel Durkee, McPherson, Kansas  
Producing formation \_\_\_\_\_ Depth to top \_\_\_\_\_ Bottom \_\_\_\_\_ Total Depth of Well 3420 Feet  
Show depth and thickness of all water, oil and gas formations.

OIL, GAS OR WATER RECORDS

CASING RECORD

FORMATION	CONTENT	FROM	TO	SIZE	PUT IN	PULLED OUT
				8-5/8	138'	None

Describe in detail the manner in which the well was plugged, indicating where the mud fluid was placed and the method or methods used in introducing it into the hole. If cement or other plugs were used, state the character of same and depth placed, from 138-93 feet to 20-5 feet for each plug set.

Gunned pits and circulated heavy mud on bottom. Laved down half of drill pipe, gunned pits and circulated heavy mud at half way out of hole. Laved down all but 4 joints drill pipe, ran measuring line and filled hole with heavy mud to 137'. Made bridge with plug and rock and 1/2 sack hulls and mixed 15 sacks cement and put through drill pipe. Laved down rest of drill pipe and ran measuring line and filled hole to 20' with heavy mud bridge with plug and 1/2 sack hulls and mixed 5 sacks cement and filled to bottom of cellar floor. Thru plugging at 7 AM.

(If additional description is necessary, use BACK of this sheet)

Name of Plugging Contractor E. K. Carey Contractor  
Address Box 620, McPherson, Kansas

STATE OF Kansas, COUNTY OF McPherson, ss.  
Arland Bruce (employee of owner) or (owner or operator) of the above-described


well, being first duly sworn on oath, says: That I have knowledge of the facts, statements, and matters herein contained and the log of the above-described well as filed and that the same are true and correct. So help me God.

(Signature) Arland Bruce  
Box 620, McPherson, Kansas  
(Address)

SUBSCRIBED AND SWORN to before me this 31st day of January, 19 56

My commission expires November 13, 1956

Notary Public.

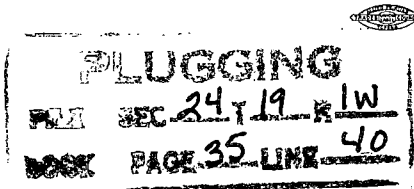

2-1-56



ROTARY DRILLER'S LOG

Mundy Shepard et al  
321 W. 1st. Street  
Freemont, Nebraska

Elevations: 1589 K.B.  
1586 D.F.  
1584 Gr.

Leffler #1

Casing Record:

C, NE SW NW,  
Sec. 24-19-1W  
McPherson County, Kansas

8-5/8" @ 138' w/110 sks.  
pozmix cement and 200# cc.

Well Commenced: 1-16-56  
Well Completed: 1-31-56 D & A

Contractor: E. K. Carey Contractor, Rig #2, Box 620, McPherson, Kansas  
Geologist: Vic Rieserer, Wichita, Kansas

Figures Indicate Bottom of Formation K. B.

Base and cellar	8
Shale	40
Shale and lime	435
Lime and shale	840
Shale and lime	1760
Lime and shale	2095
Sand, shale and lime	2160
Shale and sand	2246
Shale and lime	2318
Kansas City lime	2365
Lime	2640
Lime and shale	2870
Shale and lime	2902
Sand and shale	2916
Lime (Miss.)	3010
Lime	3160
Shale and lime	3195
Shale	3270
Shale and shells	3406
Viola lime	3420 TD

Geologist Tops:

Kansas City	2338
Miss.	2916
Viola	3406
Rotary Total Depth	3420

DST - 2920-2940' or 20' anchor.  
Tool open 1 hr. with strong blow,  
gas to surface in 2 min. 1 oz. gas  
pressure, decreased to 1/2 oz. in  
1 hr. Closed 20 min. for BHP. Rec.  
45' H.O.C.M., 60' oil cut salt water,  
180' salt water. BHP 705#.

This is to certify that the above information is to the best of my knowledge true and correct.

SUBSCRIBED AND SWORN to before me this 31st day of January, 1956

E. K. CAREY CONTRACTOR

BY Herbert Rhoton  
Herbert Rhoton, Superintendent

[Signature]

NP

My Commission Expires: November 13, 1956

**PLUGGING**  
FILE SEC 24 T 19 R 1W  
BOOK PAGE 35 LINE 40

RECEIVED  
FEB 1 1956  
DIVISION