


15-113-00506-00-00

WELL PLUGGING RECORD

Make Return Completely  
Mail or Deliver Report to:  
Conservation Division  
State Corporation Commission  
211 No. Broadway  
Wichita, Kansas

T - 18 NORTH R - 1W

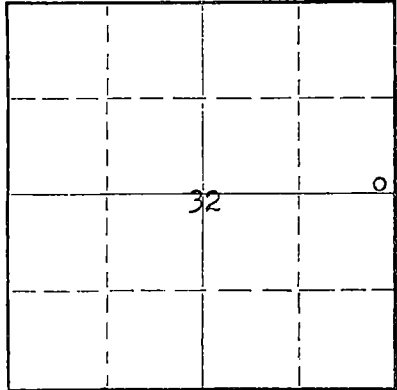

Locate well correctly on above Section Plat

McPherson County, Sec. 32 Twp. 18 Rge. 1 (E) W (W)  
Location as "NE/CNW/SW" or footage from lines SE SE NE  
Lease Owner Frank J. Black  
Lease Name Kohen Well No. 1  
Office Address McPherson, Kansas  
Character of Well (completed as Oil, Gas or Dry Hole) Oil  
Date well completed 6-11-56 19  
Application for plugging filed 5-10-63 19  
Application for plugging approved 5-13-63 19  
Plugging commenced 6-11-63 19  
Plugging completed 6-20-63 19  
Reason for abandonment of well or producing formation Depleted.

If a producing well is abandoned, date of last production 19  
Was permission obtained from the Conservation Division or its agents before plugging was commenced? yes

Name of Conservation Agent who supervised plugging of this well Cecil Jones  
Producing formation Depth to top Bottom Total Depth of Well 2896 Feet  
Show depth and thickness of all water, oil and gas formations.

OIL, GAS OR WATER RECORDS

CASING RECORD

FORMATION	CONTENT	FROM	TO	SIZE	PUT IN	PULLED OUT
				8-5/8"	155'	None
				5-1/2"	2887'	2260'

Describe in detail the manner in which the well was plugged, indicating where the mud fluid was placed and the method or methods used in introducing it into the hole. If cement or other plugs were used, state the character of same and depth placed, from feet to feet for each plug set.

Checked hole to 2460', found bridge, pumped ~~load~~ load of hot salt water in casing. Sanded to 2870' and dumped 5 sacks of cement with dump bailer. Pulled 5 1/2" casing. Mudded hole to 155', set rock bridge and filled to base of cellar with 2 yards of ready mix cement.

PLUGGING COMPLETE.

RECEIVED  
STATE CORPORATION COMMISSION

JUN 27 1963 6-27-1963

(If additional description is necessary, use BACK of this sheet)  
Name of Plugging Contractor KNIGHT CASING PULLING COMPANY  
Address CHASE, KANSAS  
CONSERVATION DIVISION  
Wichita, Kansas

STATE OF KANSAS, COUNTY OF RICE, ss.  
Noel J. Knight (employee of owner) or (owner/operator) of the above-described well, being first duly sworn on oath, says: That I have knowledge of the facts, statements, and matters herein contained and the log of the above-described well as filed and that the same are true and correct. So help me God.

(Signature) Noel J. Knight  
Chase, Kansas  
(Address)

SUBSCRIBED AND SWORN TO before me this 24th day of June, 1963

My commission expires May 20, 1964

Milton J. Volin  
Notary Public.


WELL LOG BUREAU - KANSAS GEOLOGICAL SOCIETY  
 509 East Murdock, Wichita, Kansas

Company: GREENLAND DRILLING CO.  
 Farm: Kochn. No. 1

SEC. 32 T. 18 R. 11  
 SE SE NE

Total Depth. 2896'  
 Comm. 6-4-56 Comp. 6-11-56  
 Shot or Treated.  
 Contractor. Greenland Drlg.  
 Issued. 8-11-56

County McPherson  
 KANSAS

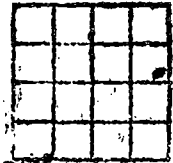

CASING:  
 8 5/8" 155'  
 5 1/2" 2887'

Elevation. 1523' RB

Production. 25 BOPD

Figures indicate bottom of formations:

shale & shalls	180
shale & lime	345
lime w/shale	355
shale & lime	510
red bed	525
lime & shale w/sandy streaks	625
lime & shale	810
shale & lime	1000
lime & shale	1040
sandy shale & lime	1180
sand & shale	1235
shale & lime	2162
sand & shale	2193
lime & shale	2500
lime w/shale strks	2544
shale & lime	2886
sand	2896
Total Depth	

Tops:  
 Brown Lime 2244  
 Lansing 2298  
 Cherokee Sand 2886

15-113-00506-00-00

**RECEIVED**  
 STATE CORPORATION COMMISSION

MAY 13 1963

CONSERVATION DIVISION  
 Wichita, Kansas