


STATE OF KANSAS
STATE CORPORATION COMMISSION

WELL PLUGGING RECORD

Give All Information Completely
Make Required Affidavit
Mail or Deliver Report to
Conservation Division
State Corporation Comm.
245 North Water
Wichita, KS 67202

McPherson County, Sec. 13 Twp. 19s Rge. 3 W E/W
Location as "NE/CNW $\frac{1}{4}$ SW $\frac{1}{4}$ " or footage from lines _____
C SW NE
Lease Owner George Hess & Sons
Lease Name Swanson Well No. 2
Office Address P.O.Box 89 McPherson, Kansas
Character of Well (Completed as Oil, Gas or Dry Hole) oil

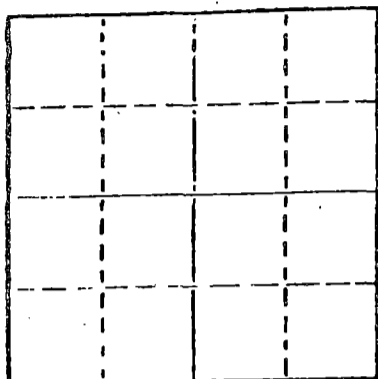

Locate well correctly on above
Section Plat

Date Well completed 12-20 1956
Application for plugging filed 10-14 1977
Application for plugging approved 10-15 1977
Plugging commenced 10-17 1977
Plugging completed 10-26 1977
Reason for abandonment of well or producing formation _____

If a producing well is abandoned, date of last production 19 _____

Was permission obtained from the Conservation Division or
its agents before plugging was commenced? yes

Name of Conservation Agent who supervised plugging of this well Hugh Scott
Producing formation _____ Depth to top _____ Bottom _____ Total Depth of Well 3021'
Show depth and thickness of all water, oil and gas formations.

OIL, GAS OR WATER RECORDS

CASING RECORD

FORMATION	CONTENT	FROM	TO	SIZE	PUT IN	PULLED OUT
				5 1/2"		1833'

Describe in detail the manner in which the well was plugged, indicating where the mud fluid was placed and the method or methods used in introducing it into the hold. If cement or other plugs were used, state the character of same and depth placed, from _____ feet to _____ feet to _____ feet.

RECEIVED FOR EACH PLUG SET
STATE CORPORATION COMMISSION

OCT 31 1977

10-31-1977

CONSERVATION DIVISION
Wichita, Kansas

Plugged off bottom of hole with sand. Sand from 3021' to 3000'. Dumped 5 sx of cement. Mudded hole to 175'. Made 10' of rock bridge. Dumped 25 sx of cement. Mudded hole to 40'. Made 10' of rock bridge. Dumped 10 sx of cement, filling to the bottom of the celler.

(If additional description is necessary, use BACK of this sheet)

Name of Plugging Contractor Art Lamb Casing Pulling Inc.
2809 King St. Hutchinson, Kansas 67501

STATE OF Kansas COUNTY OF Reno ss.
Art Lamb (employee of owner) or (owner or operator) of the above-described

well, being first duly sworn on oath, says: That I have knowledge of the facts, statements, and matters herein contained and the log of the above-described well as filed and that the same are true and correct. So help me God.

(Signature) Art Lamb

2809 King St. Hutchinson, Kansas
(Address)

SUBSCRIBED AND SWORN TO before me this 28th day of October 1977

My commission expires December 31, 1977

Judy Lamb Notary Public

COMPANY: George Hess
 CONTRACTOR: Mallard Drilling Company
 FARM: Swanson #2
 LOCATION: C SW NE Sec. 13-19S-3W
 Mc Pherson County, Kansas
 COMMENCED: December 14, 1956
 COMPLETED: December 20, 1956

0	to	75	Sand
75	to	155	Shale
155	to	390	Shale
390	to	650	Lime
650	to	885	Lime
885	to	1140	Shale and lime
1140	to	1800	Shale and lime
1800	to	2310	Shale and lime
2310	to	2395	Lime
2395	to	2505	Lime
2505	to	2710	Shale and lime
2710	to	2960	Shale and lime
2960	to	2964	Shale
2964	to	3021	Mississippi
		3021	T.D. Rotary

RECEIVED
 STATE CORPORATION COMMISSION
 OCT 17 1977
 CONSERVATION DIVISION
 Wichita, Kansas

Set 155 feet of 8 5/8" surface pipe. Cemented with 100 sacks cement.
 Set 5 1/2" at 3013. Cemented with 40 sacks cement, 10 sacks in rat hole.
 TOPS: Missippi -- 2964
 Measurements taken from R.D.B. R.D.B. 5 1/2' from ground level.

C E R T I F I C A T E

I, C. C. Nelson, do hereby certify that the above and foregoing is a true and correct copy of log of the Swanson #2, Mc Pherson County, Kansas, as reflected by files of the Mallard Drilling Company.

C. C. Nelson

Subscribed and sworn to before me a Notary Public, within and for Sedgwick County, Kansas as reflected by files of the Mallard Drilling Company.

Robert P. Hurd

My commission expires November 16, 1959