

STATE OF KANSAS
STATE CORPORATION COMMISSION


WELL PLUGGING RECORD

OR
FORMATION PLUGGING RECORD

Strike out upper line
when reporting plug-
ging off formations.

Give All Information Completely
Make Required Affidavit
Mail or Deliver Report to:
Conservation Division
State Corporation Commission
800 Bittling Building
Wichita, Kansas

NORTH

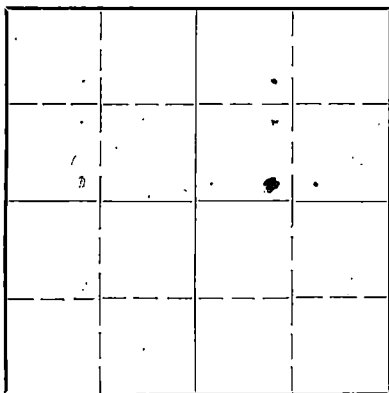

Locate well correctly on above
Section Flat

McPherson

County, Sec. 13 Twp. 19 Rge. (E) 3 (W)

Location as "NE 1/4 NW 1/4 SW 1/4" or footage from lines 330 Ft. from S 990 from W

Lease Owner Nadel & Gussman Oil Co.

Lease Name Swanson

Well No. 3

Office Address P.O. Box 996 Tulsa Okla.

Character of Well (completed as Oil, Gas or Dry Hole) Oil Producing Well

Date well completed 19

Application for plugging filed June 1 19 43

Application for plugging approved Aug. 4 19 43

Plugging commenced Aug. 5 19 43

Plugging completed Aug. 20 19 43

Reason for abandonment of well or producing formation Well produce 95% Water
5 Bbls of oil aday the operating expence was grate

If a producing well is abandoned, date of last production May 15 19 43

Was permission obtained from the Conservation Division or its agents before plugging was com-
menced? Yes

Name of Conservation Agent who supervised plugging of this well Ruel Durkee

Producing formation Chat Depth to top 2999 Bottom 3012 Total Depth of Well 3012 Feet

Show depth and thickness of all water, oil and gas formations. 13 Ft. of penetration

OIL, GAS OR WATER RECORDS

CASING RECORD

Formation	Content	From	To	Size	Put In	Pulled Out
Chat	20"	0	74 Ft.	20"	74 Ft.	74 Ft.
	8 5/8"	0	3011	8 5/8"	3011 Ft.	2.649'8"
	7" O.D.	0	2999'	70D	2999 Ft.	2.879'4"

Describe in detail the manner in which the well was plugged, indicating where the mud fluid was placed and the method or methods used in introducing it into the hold. If cement or other plugs were used, state the character of same and depth placed, from 2999' 3012 feet to 2999' up 2939' feet for each plug set.

Mud
mud 3012' up 2999' with mud 10 sacks of cement 2999' up to 2939' 60 Ft. of
cement 40 sacks of cement at 175 Ft. muded up to the base of seller 10
sacks of cement in the base of seller

PLUGGING
FILE 13 19 30
BOOK PAGE 75 LINE 13

STATE CORPORATION COMMISSION
OCT - 1 1943
STATE CORPORATION COMMISSION
SEP 1 - 1943
10-1-43

(If additional description is necessary, use BACK of this sheet)

Correspondence regarding this well should be addressed to Nadel & Gussman Oil Co.
Address P.O. Box 996 Tulsa Oklahoma

STATE OF Kansas, COUNTY OF McPherson, ss.
A.M. Jones Prod. Supt. (employee of owner) or (owner or operator) of the above-described well,

being first duly sworn on oath, says: That I have knowledge of the facts, statements, and matters herein contained and the log of the above-described well as filed and that the same are true and correct. So help me God.

(Signature) A.M. Jones
P.O. Box 123 McPherson Kansas (Address)

SUBSCRIBED AND SWORN to before me this 29 day of September, 19 43

My commission expires May 13, 1945
Notary Public




MATERIAL REPORT AND PLUGGING RECORD

Mail To: STATE CORPORATION COMMISSION
Conservation Division
800 Bitting Building
Wichita, Kansas

NOTICE: All questions on this form must be answered.

Company Operating Nadel and Gussman
Office Address P. O. Box 996, Tulsa, Oklahoma

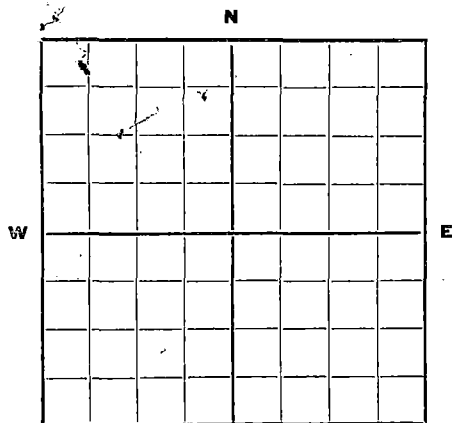

Locate well correctly.

County McPherson Sec. 13 Twp. 19 Rge. 3

Farm Name Swanson Well No. 3 Field Chindberg

Well Location 330' from S., 990' from W.

Name of Producing Sand Chat Total Depth 3012'

Commenced Plugging August 5, 1943 Finished August 20, 1943.

DAILY AVERAGE PRODUCTION:

Initial Production: Oil _____ Gas _____ Water _____

Production when Plugged: Oil 5% Gas _____ Water 95%

Estimated Total Remaining Reserves Attributable to Well at Time Abandoned None

INFORMATION ON MATERIALS RECLAIMED FROM WELL

CASING, TUBING AND ROD DATA

Description	Size	Recovered		Junk		Reusable		Disposition Made Or To Be Made Of Usable Material
		Ft.	Tons	Ft.	Tons	Ft.	Tons	
7" Casing		2947'				2900'		To Be Sold
8 5/8" Casing		2651'				2600'		To Be Sold
20" Casing		73'	7"			73'		Sold to Hermann Kaiser Pipe & Supply, Tulsa, Oklahoma

SURFACE EQUIPMENT

Quantity	Description	*Condition	Est. Tons	Disposition Made Or To Be Made Of Reclaimed Material
1	25 H.P. Superior Engine	Fair		To Be Used as Replacemnt on other lease

* Usable, Usable with minor repairs, or junk.

Date August 30, 1943 Signed: [Signature]

(For Operating Co.—Title)

13 19 30
75 13



It is very important that all questions on this form be answered, as this Department has been asked by the Petroleum Administration for War to supply data on well abandonments undertaken during the war.

This information is very essential in aiding the war effort; therefore, this Department is requiring this report to be mailed within 5 days after the abandonment of your well.

19-6756

Copy of Log

Well #3

SWANSON 13-19-3W
McPherson County, Kansas

CASING RECORD: 73 ft. 20"
 3011 ft. 8 5/8"
 3014 ft. 7"

<u>FORMATION</u>	<u>DEPTH</u>	
Red Rock	130'	10 BFWPH 140
Yellow shale	1330	3 BWS
Lime	1445	1 BSW
Lime	1820	1772-1788
Sandy shale	2140	HFW 2160
Gray shale	2336	showing of oil
Lime hard	2513	HFW 2475
Chat gas	2999	
Chat oil	3007	
Chat no pay	3012	T.D.

INDEXING
FILE SEP 13 1934
BOOK PAGE 95 LINE 13

