

STATE CORPORATION COMMISSION OF KANSAS  
OIL & GAS CONSERVATION DIVISION

WELL COMPLETION OR RECOMPLETION FORM  
ACO-1 WELL HISTORY

DESCRIPTION OF WELL AND LEASE

Operator: License # 5004  
Name Vincent Oil Corporation  
Address 125 N. Market - Suite 1110  
City/State/Zip Wichita, Kansas 67202

Purchaser N/A

Operator Contact Person June K. Burnett  
Phone 316-262-3573

Contractor: License # 5149  
Name Wheatstate Oilfield Services, Inc.

Wellsite Geologist Chuck Schwalz  
Phone 316-838-1136

Designate Type of Completion  
 New Well  Re-Entry  Workover  
 Oil  SWD  Temp Abd  
 Gas  Inj  Delayed Comp.  
 Dry  Other (Core, Water Supply etc.)

If OWWO: old well info as follows:  
Operator  
Well Name  
Comp. Date Old Total Depth

WELL HISTORY

Drilling Method:  
 Mud Rotary  Air Rotary  Cable

10/15/85 10/25/85 10/26/85  
Spud Date Date Reached TD Completion Date  
5070  
Total Depth PBTD

Amount of Surface Pipe Set and Cemented at 519 feet  
Multiple Stage Cementing Collar Used?  Yes  No  
If yes, show depth set... feet  
If alternate 2 completion, cement circulated from... feet depth to... w/... SX cmt

API NO. 15-097-21.186-0000

County Kiowa  
100' N. of C. NW SE Sec. 4 Twp. 30 Rge. 18  East  West


2080 Ft North from Southeast Corner of Section  
1980 Ft West from Southeast Corner of Section  
(Note: Locate well in section plat below)

Lease Name Parkin "C" Well # J

Field Name Parkin

Producing Formation N/A

Elevation: Ground 2216 KB 2228  
Section Plat

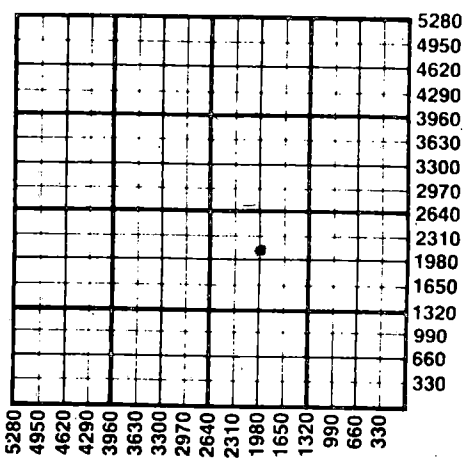

WATER SUPPLY INFORMATION

Disposition of Produced Water:  Disposal  Repressuring  
Docket #

Questions on this portion of the ACO-1 call:  
Water Resources Board (913) 296-3717

Source of Water:  
Division of Water Resources Permit #

Groundwater... Ft North from Southeast Corner (Well) ... Ft West from Southeast Corner of Sec Twp Rge  East  West

Surface Water... Ft North from Southeast Corner (Stream, pond etc) ... Ft West from Southeast Corner Sec Twp Rge  East  West

Other (explain) (purchased from city, R.W.D. #)


INSTRUCTIONS: This form shall be completed in duplicate and filed with the Kansas Corporation Commission, 200 Colorado Derby Building, Wichita, Kansas 67202, within 90 days after completion or recompletion of any well. Rule 82-3-130 and 82-3-107 apply. Information on side two of this form will be held confidential for a period of 12 months if requested in writing and submitted with the form. See rule 82-3-107 for confidentiality in excess of 12 months. One copy of all wireline logs and drillers time log shall be attached with this form. Submit CP-4 form with all plugged wells. Submit CP-111 form with all temporarily abandoned wells.

All requirements of the statutes, rules and regulations promulgated to regulate the oil and gas industry have been fully complied with and the statements herein are complete and correct to the best of my knowledge.

Signature Richard A. Hiebsch  
Title Vice-President Date 11-12-85

Subscribed and sworn to before me this 12th day of November 1985  
Notary Public June K. Burnett  
Date Commission Expires March 30, 1989

K.C.C. OFFICE USE ONLY  
F  Letter of Confidentiality Attached  
C  Wireline Log Received  
C  Drillers Timelog Received  
Distribution  
 KCC  SWD/Rep  NGPA  
 KGS  Plug  Other  
(Specify)

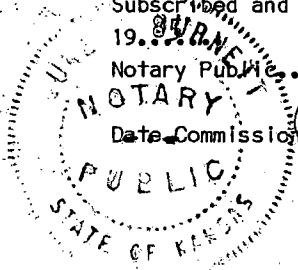

RECEIVED  
DEC 4 1985  
CONSERVATION DIVISION  
Wichita, Kansas

Sec. 4 Twp. 30 Rge. 18W

SIDE TWO

Operator Name Vincent Oil Corporation Lease Name Parkin "C" Well # J

Sec. 4 Twp. 30 Rge. 18  East  West County Kiowa

WELL LOG

INSTRUCTIONS: Show important tops and base of formations penetrated. Detail all cores. Report all drill stem tests giving interval tested, time tool open and closed, flowing and shut-in pressures, whether shut-in pressure reached static level, hydrostatic pressures, bottom hole temperature, fluid recovery, and flow rates if gas to surface during test. Attach extra sheet if more space is needed. Attach copy of log.

Drill Stem Tests Taken  Yes  No  
 Samples Sent to Geological Survey  Yes  No  
 Cores Taken  Yes  No

Formation Description  
 Log  Sample

Name	Top	Bottom
Stotler	3429	(-1261)
Emporia	3566	(-1338)
Heebner	4190	(-1962)
Brown Lime	4366	(-2138)
Lansing-Kansas City	4385	(-2157)
Base Kansas City	4788	(-2560)
Marmaton	4858	(-2630)
Cherokee	4928	(-2700)
Mississippian	5004	(-2776)
LTD	5065	


DST #1: 4827' - 4880'; 30-30-15-30; 1st open - weak blow decreasing  
 2nd open - no blow, flushed tool, no help  
 Recovered: 15' mud  
 IFP 42 - 42# ISIP 42#  
 FFP 52 - 52# FSIP 52#  
 BHT - 124 degrees

CASING RECORD <input checked="" type="checkbox"/> New <input type="checkbox"/> Used							
Report all strings set-conductor, surface, intermediate, production, etc.							
Purpose of String	Size Hole Drilled	Size Casing Set (in O.D.)	Weight Lbs/Ft.	Setting Depth	Type of Cement	#Sacks Used	Type and Percent Additives
surface	12 1/4	8 5/8	23#	519	Lite Class A	200	3%cc
						100	3%cc 2%gel
PERFORATION RECORD				Acid, Fracture, Shot, Cement Squeeze Record			
Shots Per Foot	Specify Footage of Each Interval Perforated			(Amount and Kind of Material Used)		Depth	
TUBING RECORD				Liner Run <input type="checkbox"/> Yes <input type="checkbox"/> No			
Date of First Production	Producing Method <input type="checkbox"/> Flowing <input type="checkbox"/> Pumping <input type="checkbox"/> Gas Lift <input type="checkbox"/> Other (explain).....						
Estimated Production Per 24 Hours	Oil	Gas	Water	Gas-Oil Ratio	Gravity		
	Bbls	MCF	Bbls	CFPB			

METHOD OF COMPLETION

Production Interval

Disposition of gas:  Vented  Open Hole  Perforation  
 Sold  Other (Specify) .....  
 Used on Lease  Dually Completed  Commingled

 

ACO-1 WELL HISTORY

PAGE 2 (Side One)

OPERATOR Vincent Oil Corp. LEASE NAME Parkin "C"  
 WELL NO. 1

SEC 4 TWP 30S RGE 18 (W)

FILL IN WELL INFORMATION AS REQUIRED.

Show all important zones of porosity and contents thereof; cored intervals, and all drill-stem tests, including depth interval tested, cushion used, time tool open, flowing & Shut-in pressures, and recoveries.

Show Geological markers, logs run, or Other Descriptive information.

FORMATION DESCRIPTION, CONTENTS, ETC.	TOP	BOTTOM	NAME	DEPTH
DST #2: 4883' - 4988'; 45-60-45-60;	1st open 2nd open Recovered:	weak blow fair blow 90' gas 150' gas 60' gas	increasing to good blow to weak blow in pipe cut mud with specks oil cut muddy water with scum oil (50% water - cl. 80,000)	
	IFP 117 - FFP 148 - BHT - 125	127# 148# degrees	ISIP 1610# FSIP 1157#	
DST #3: 5010' - 5044': MISRUN - PACKER FAILURE				
DST #4: 5017' - 5050'; 30-45-45-60;	1st open 2nd open Recovered:	fair blow strong blow 1080' gas 150' gas 90' gas	increasing to strong blow throughout in pipe cut mud cut water mud (20% water) CL. 41,000 - mud cl. 18,000	
	IFP 85 - FFP 106 - BHT - 125	95# 106# degrees	ISIP 595# FSIP 574#	
DST #5: 3561' - 3618': Hookwall Straddle MISRUN - Hook would not set				
DST #6: 3561' - 3604': Hookwall Straddle MISRUN - PACKER FAILURE Recovered: 2250' mud, no show				

RECEIVED  
STATE CORPORATION COMMISSION

DEC 2 1961

## INSTRUCTIONS FOR FILING ACO-1 WELL HISTORY FORMS

## When to File - Number of Copies

PLEASE FILL OUT ALL INFORMATION. IF INFORMATION IS NOT AVAILABLE, INDICATE. IF INFORMATION LATER BECOMES AVAILABLE, SUBMIT BY LETTER.

ACO-1 Well history forms are required on all wells, regardless of how completed. (Rule 82-3-130)

PRODUCING AND TEMPORARILY ABANDONED WELLS:  
(File 2 copies)

**OIL WELLS:** An oil well shall be considered completed when the first new oil is produced through well head equipment into lease tanks from the producing interval after the production string has been run. For information regarding oil wells, contact Tom Leiker or Elisabeth Wannow.

**GAS WELLS:** A gas well shall be considered completed when the well is capable of producing gas through well head equipment from the producing zone after the production string has been run. Shut-in gas wells also require 2 copies. For information regarding gas wells, contact Richard Smith or Jim Hemmen.

**TEMPORARILY ABANDONED WELLS:** For information, contact Duane Rankin.

## ACO-1 WELL HISTORY FORMS WITH APPLICATIONS:

**PLUGGING:** File 3 (THREE) copies. A dry hole shall be considered completed when all provisions of plugging are complied with. ACO-1 should be filed with one copy each of form CP-1 and CP-4. For information regarding plugging, contact Allaweas Winfrey (western range) or Diana Crockett (eastern range).

**SALT WATER DISPOSAL and INJECTION:** File 4 (FOUR) copies. These should be sent with two copies of form U-1. For information regarding SWD or injection wells, contact Lu VonFeldt.

**NGPA:** File 4 (FOUR) copies. These should be filed with one original and two copies of NGPA application forms. For information, contact Becky Norris or Bob Tilton.

## REQUESTING CONFIDENTIALITY:

Only 1 (ONE) copy of the ACO-1 should be filed with a letter attached for each well on which information is to be held confidential. ALL of the information should be completed on the form. Only information on Side One will be of public record. Side Two will be held confidential. On wells which are Docketed, confidentiality is waived. Plugging forms CP-1 and CP-4 cannot be held confidential.

To order additional forms or request information, call (316) 263-3238.

PLEASE KEEP THIS SHEET FOR REFERENCE.