


R

STATE OF KANSAS
STATE CORPORATION COMMISSION

Give All Information Completely
Make Required Affidavit
Mail or Deliver Report to:
Conservation Division
State Corporation Commission
P. O. Box 17027
Wichita, Kansas 67217
NORTH

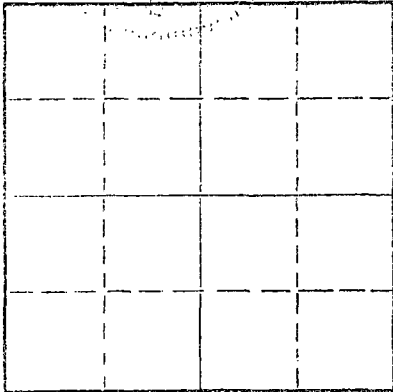

Locate well correctly on above
Section Plat

WELL PLUGGING RECORD

Barton County, Sec. 25 Twp. 20S Rge. 11 (EX W (W))
Location as "NE/CNWSW" or footage from lines 990' N-440' E of W/4 Cor. Sec.
Lease Owner Cities Service Oil Company
Lease Name R. Bryant "A" Well No. 2
Office Address Box 308, Great Bend, Kansas 67530
Character of Well (completed as Oil, Gas or Dry Hole) Oil
Date well completed July 30 19 37
Application for plugging filed June 7 19 72
Application for plugging approved June 8 19 72
Plugging commenced June 21 19 72
Plugging completed June 24 19 72
Reason for abandonment of well or producing formation Depleted

If a producing well is abandoned, date of last production 19
Was permission obtained from the Conservation Division or its agents before plugging was commenced? Yes

Name of Conservation Agent who supervised plugging of this well Donald Truan
Producing formation Arbuckle Depth to top 3270' Bottom 3295' Total Depth of Well 3295 Feet
Show depth and thickness of all water, oil and gas formations.

OIL, GAS OR WATER RECORDS

CASING RECORD

FORMATION	CONTENT	FROM	TO	SIZE	PUT IN	PULLED OUT
				10"	242'	-0-
				7"	3270'	1516'

Describe in detail the manner in which the well was plugged, indicating where the mud fluid was placed and the method or methods used in introducing it into the hole. If cement or other plugs were used, state the character of same and depth placed, from feet to feet for each plug set.

Plug Back with Sand 3295-3250'
6 Sacks Cement 3250-3220'
Mud 3220- 255'
1 Sack Halls 255- 250'
125 Sacks Cement 250- 0'

6-30-1972
RECEIVED
STATE CORPORATION COMMISSION
JUN 30 1972
CONSERVATION DIVISION
Wichita, Kansas

(If additional description is necessary, use BACK of this sheet)
Name of Plugging Contractor Southwest Casing Pulling Company
Address 1920 16th Street, Great Bend, Kansas 67530

STATE OF Kansas, COUNTY OF Barton, ss.
W. J. Devaney

(employee of owner) or (owner/owner's agent) of the above-described well, being first duly sworn on oath, says: That I have knowledge of the facts, statements, and matters herein contained and the log of the above-described well as filed and that the same are true and correct. So help me God.


(Signature)

W. J. Devaney District Manager
Box 308, Great Bend, Kansas 67530
(Address)

Subscribed and sworn to before me this 29th day of June 1972

My commission expires June 3, 1973

Notary Public.

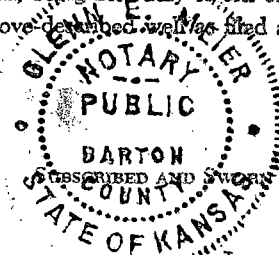

WELL RECORD

15.009.14722.0000

Company (ITIO) Cities Service Oil Co. Well No. 2 Farm Rose Bryant "A"
 Location 990' north and 440' east of W/4 Corner Sec. 25 T. 20 R. 11W
 Elevation 1759 County Barton State Kansas
 Drig. Comm. July 4, 1937 Contractor Arrow Drilling Company
 Drig. Comp. July 25, 1937 Acid None
 T. D. 3295' Initial Prod. 1733 oil, no water, 24 hrs. - Physical Test

CASING RECORD:

10" @ 242' cem. 175 sacks
 7" @ 3270' cem. 190 sacks

FORMATION RECORD:

sand	105
clay	207
clay and sand	242
sand & shells	360
shale & shells	1150
broken salt	1340
shale & shells	1386
shale & broken lime	1464
salt	1494
shale & shells	1620
anhydrite	1728
broken anhydrite	1750
shale	1853
shale & sand	2004
lime & shale	2115
shale & lime shells	2240
shale & shells	2379
lime & shale	2430
shale & shells	2530
lime	2550
lime & shale	2669
lime	2720
shale & shells	2756
lime	2816
lime & shale	2887
brown lime	2960
shale	2985
broken lime	3025
lime	3270
lime, soft	3274' 10"
siliceous lime	3284
siliceous lime (3200' oil in hole)	3290

Top Kansas City
 Top Arbuckle
 Penetration
 Total Depth

3020'
 3262' 3269' 10"
 27' 25' 16"
 3295'

Vertical Tests: 500' 1/2°
 1000' 1/2°

RECEIVED
 STATE CORPORATION COMMISSION
 JUN 8 1972
 CONSERVATION DIVISION
 Wichita, Kansas

3020
 1759
 -1261
 3262
 1759
 -1503