


STATE OF KANSAS
STATE CORPORATION COMMISSION

Form CP-4

Give All Information Completely
Make Required Affidavit
Mail or Deliver Report to:
Conservation Division
State Corporation Commission
P. O. Box 17027
Wichita, Kansas 67217

WELL PLUGGING RECORD

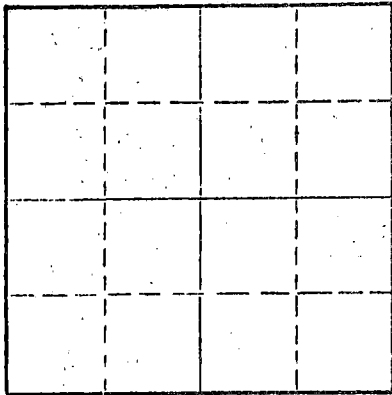

Locate well correctly on above
Section Plat

Kiowa County, Sec. 7 Twp. 28S Rge. (E) 20 (W)
Location as "NE/CNW/SW" or footage from lines. C W 1/2 SW
Lease Owner. Barnett Oil Company
Lease Name. Yung Well No. 1
Office Address. 411 First Nat'l Bk Bldg., Wichita, Ks.
Character of Well (completed as Oil, Gas or Dry Hole) Dry Hole
Date well completed December 28, 1973
Application for plugging filed 19
Application for plugging approved 19
Plugging commenced December 28, 1973
Plugging completed December 28, 1973
Reason for abandonment of well or producing formation Dry Hole

If a producing well is abandoned, date of last production 19
Was permission obtained from the Conservation Division or its agents before plugging was commenced? Yes (G. Russell Biberstein of Attica)

Name of Conservation Agent who supervised plugging of this well
Producing formation Depth to top Bottom Total Depth of Well 5065 Feet
Show depth and thickness of all water, oil and gas formations.

OIL, GAS OR WATER RECORDS

CASING RECORD

FORMATION	CONTENT	FROM	TO	SIZE	PUT IN	PULLED OUT
	Surface	0	529'	8-5/8"	529'	None
	Casing					

Describe in detail the manner in which the well was plugged, indicating where the mud fluid was placed and the method or methods used in introducing it into the hole. If cement or other plugs were used, state the character of same and depth placed, from feet to feet for each plug set.

Heavy Mud from Total Depth to 420 Feet,
Plug and 50 sax Cement; Heavy Mud to 40
Feet, 1/2 sax Halls, Plug Bridged and 12
sax Cement to Base of Cellar; 3 sax
Cement in Rat Hole. Job Completed @
8:00 P.M.

RECEIVED
STATE CORPORATION COMMISSION
1-9-74
JAN 9 1974
CONSERVATION DIVISION
Wichita, Kansas

Name of Plugging Contractor Allied Cementing Co.
Address Box 207, Russell, Kansas


STATE OF KANSAS COUNTY OF SEDGWICK
T.M. McCaul, Jr. of Sage Drilling Co.

Subscribed and sworn to before me this 31st day of December, 1973

(Signature) T.M. McCaul Jr.
500 Bitting Bldg., Wichita, Ks. 67202
(Address)

Subscribed and sworn to before me this 31st day of December, 1973

(Signature) Louise K. Whitted
Louise K. Whitted Notary Public.

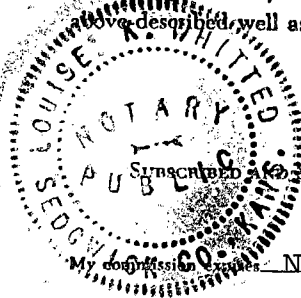

November 26, 1974.

RECEIVED
STATE CORPORATION COMMISSION

JAN 9 1974

CONSERVATION DIVISION
Wichita, Kansas

DRILLERS LOG

YUNG NO. 1

CASING RECORD:	OPERATOR: Barnett Oil Company	DESCRIPTION:
8-5/8" set @ 529' w/400 sax cement	CONTRACTOR: Sage Drilling Co.	C W/2 SW Sec. 7-28S-20W Kiowa Co., Kansas
TOTAL DEPTH: 5065'	COMMENCED: December 14, 1973	ELEVATION: 2327KB
	COMPLETED: December 28, 1973	

<u>FORMATION</u>	<u>FROM</u>	<u>TO</u>	<u>REMARKS</u>
Sand & Clay	0	90	
Shale	90	520	
Anhydrite	520	545	
Shale	545	795	
Shale & Red Bed	795	950	
Lime & Shale	950	1965	
Shale & Lime	1965	2230	
Lime	2230	5065	D&A

I certify that this is a true and correct copy of the above log to the best of my knowledge.

SAGE DRILLING CO., INC.

By *T. M. McCaul, Jr.*
T. M. McCaul, Jr.



Subscribed and sworn to before me this 31st day of December, 1973.

Louise K. Whitted
Louise K. Whitted, Notary Public

My commission expires:
November 26, 1974.