


STATE OF KANSAS
STATE CORPORATION COMMISSION

WELL PLUGGING RECORD

Give All Information Completely
Make Required Affidavit
Mail or Deliver Report to:
Conservation Division
State Corporation Commission
212 North Market, Insurance Bldg.
Wichita, Kansas

Kiola County. Sec. 24 Twp. 30S Rge. (E) 16 (W)

Location as "NE/CNW%SW%" or footage from lines 2390'N & 1270'E of SW corner
Lease Owner Shell Oil Company
Lease Name ROBBINS UNIT Well No. 1-24
Office Address 1845 Sherman Street, Denver 3, Colorado
Character of Well (completed as Oil, Gas or Dry Hole) Dry Hole
Date well completed February 2 19 61
Application for plugging filed February 6 19 61
Application for plugging approved (verbal) February 2 19 61
Plugging commenced February 2 19 61
Plugging completed February 2 19 61
Reason for abandonment of well or producing formation -

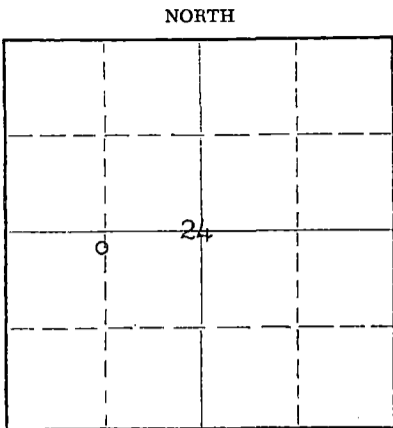

Locate well correctly on above
Section Plat

If a producing well is abandoned, date of last production - 19
Was permission obtained from the Conservation Division or its agents before plugging was commenced? Yes

Name of Conservation Agent who supervised plugging of this well W. L. Lackamp, Jr.
Producing formation Mississippian Depth to top 4494 Bottom 4555 Total Depth of Well 4698 Feet
Show depth and thickness of all water, oil and gas formations. Viola 4596

OIL, GAS OR WATER RECORDS

CASING RECORD

FORMATION	CONTENT	FRDM	TO	SIZE	PUT IN	PULLED OUT
Mississippian	Dry	4494	4555	8 5/8"	476'	None
Viola	Dry	4596	4698			

Describe in detail the manner in which the well was plugged, indicating where the mud fluid was placed and the method or methods used in introducing it into the hole. If cement or other plugs were used, state the character of same and depth placed, from feet to feet for each plug set.

RECEIVED
STATE CORPORATION COMMISSION

FEB 2 1961

Filled hole with heavy mud to 375'.
Set plug; used 1/3 sack hulls & Halliburton plug.
Pumped in 35 sax cement; cementing back to 263'.
Filled hole with heavy mud to 40'.
Set plug; used 1/2 sack hulls & Halliburton plug.
Pumped in 15 sax cement; cementing to base of cellar.

(If additional description is necessary, use BACK of this sheet)

Name of Plugging Contractor Sierra Petroleum Co., Inc.
Address 208 Petroleum Building, Wichita 2, Kansas

STATE OF Colorado, COUNTY OF Denver, ss.
J. E. Tuttle (employee of owner) or (owner or operator) of the above-described well, being first duly sworn on oath, says: That I have knowledge of the facts, statements, and matters herein contained and the log of the above-described well as filed and that the same are true and correct. So help me God.

(Signature) J. E. Tuttle
J. E. Tuttle, Division Exploitation Engineer
1845 Sherman Street, Denver 3, Colorado
(Address)

SUBSCRIBED AND SWORN TO before me this 6th day of February, 19 61

Donna M. Mastain
Notary Public.

My commission expires September 15, 1962



Shell-Robbins Unit No. 1-24
2390' North and 1270' East of SWc
Section 24-30S-16W
Glick Field
Kiowa County, Kansas

Casing Record

8 5/8" cem 416 with 300 sax; cem circ.

- 0 - 60 surface clay & sand
- 415 red bed
- 655 red bed & gyp
- 680 anhydrite
- 850 shale & shells
- 1000 salt & shale
- 1115 shale, shells & gyp
- 1530 shale & shells
- 1900 shale, shells & gyp
- 2060 shale, gyp & lime
- 2545 lime & shale
- 3165 shale & lime
- 3280 lime & shale
- 3395 lime
- 3515 shale & lime
- 3630 lime & shale
- 3745 lime
- 3856 lime & shale
- 3924 shale & lime
- 4305 lime
- 4582 lime & shale
- 4701 lime
- 4701=4700 TD (driller)
- 4698 TD (Schlumberger)

Schlumberger Tops:
 Lansing-Kansas City 3936
 Cherokee 4446
 Mississippian 4494
 Viola 4596

RECEIVED
STATE CORPORATION COMMISSION

FEB 23 1961

CONSERVATION DIVISION
Wichita, Kansas