


STATE OF KANSAS
STATE CORPORATION COMMISSION

WELL PLUGGING RECORD

Give All Information Completely
Make Required Affidavit
Mail or Deliver Report to:
Conservation Division
State Corporation Commission
211 North Broadway
Wichita, Kansas

McPherson County. Sec. 11 Twp. 19 Rge. 3 (E) 3 (W)
Location as "NE/CNW/SW" or footage from lines C NW NE SW
Lease Owner Donald T. Ingling et al
Lease Name H. Krehbiel Well No. 1
Office Address Wichita, Kansas
Character of Well (completed as Oil, Gas or Dry Hole) Dry Hole
Date well completed August 10, 1957
Application for plugging filed August 10, 1957
Application for plugging approved August 10, 1957
Plugging commenced August 10, 1957
Plugging completed August 11, 1957
Reason for abandonment of well or producing formation Dry

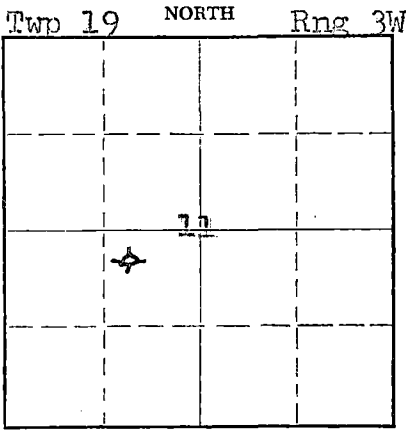

Locate well correctly on above
Section Plat

If a producing well is abandoned, date of last production _____ 19____
Was permission obtained from the Conservation Division or its agents before plugging was commenced? Yes

Name of Conservation Agent who supervised plugging of this well Ruel Durkee
Producing formation _____ Depth to top _____ Bottom _____ Total Depth of Well 3592 Feet
Show depth and thickness of all water, oil and gas formations.

OIL, GAS OR WATER RECORDS

CASING RECORD

FORMATION	CONTENT	FROM	TO	SIZE	PUT IN	PULLED OUT
				8 5/8"	180'	None

Describe in detail the manner in which the well was plugged, indicating where the mud fluid was placed and the method or methods used in introducing it into the hole. If cement or other plugs were used, state the character of same and depth placed, from _____ feet to _____ feet for each plug set.

Gun pits then circulate one hour and lay down drill pipe, put solid bridge at 170 feet, spot 15 sacks cement through 5 joints drill pipe and heavy mud to 25 feet, put bridge at 25 feet then 5 sacks cement and heavy mud to cut off point of surface pipe.

(If additional description is necessary, use BACK of this sheet)

Name of Plugging Contractor Donald T. Ingling
Address 623 1st Nat'l Bank Bldg., Wichita 2, Kansas

STATE OF KANSAS, COUNTY OF SEDGWICK, ss.
D. T. Ingling (employee of owner) or (owner or operator) of the above-described well, being first duly sworn on oath, says: That I have knowledge of the facts, statements, and matters herein contained and the log of the above-described well as filed and that the same are true and correct. So help me God.

(Signature) D. T. Ingling
Wichita, Kansas (Address)

SUBSCRIBED AND SWORN to before me this 13th day of August, 1957

STATE CORPORATION COMMISSION

M. E. Black

Notary Public.

My commission expires 2-27-60

AUG 17 1957

CONSERVATION DIVISION
Wichita, Kansas

8/17/57

PLUGGING
FILE SEC. 11 T. 19 R. 3W
BOOK PAGE 32 LINE 12

WELL LOG - H. KREHBIEL NO. 1

Donald T. Ingling et al, Lease Owner

Section 11-19-3W

Donald T. Ingling, Contractor

Location: C NW NE SW

Commenced: July 8, 1957

County: McPherson

Completed: August 11, 1957

Production: Dry

Total Depth: 3592'

Elevation: 1519 DF

Casing: 8 5/8" 180' (75 sacks cement)

Figures below indicate bottom formation.

135	shale	3120	lime
180	shale and shells	3170	lime
430	shale and shells	3185	lime
595	lime and shale streaks	3205	lime
665	lime	3238	lime
730	lime	3300	lime
860	lime	3325	lime
940	lime	3345	lime
1045	lime and shale	3371	lime
1135	lime	3390	lime - Mississippi
1210	lime and shale streaks	3400	shale
1310	shale and lime streaks	3440	shale
1435	shale and lime streaks	3490	shale
1590	lime and shale	3535	shale
1785	shale and lime streaks	3575	shale
1920	lime and shale	3580	shale
1990	lime	3592	Viola
2070	lime	3592	Total Depth
2160	lime		
2200	lime and shale streaks		
2338	shale and sandy		
2370	lime and shale		
2450	lime and shale		
2500	lime		
2545	lime		
2665	lime		
2745	lime		
2807	lime		
2950	shale and lime streaks		
3015	lime		
3082	shale and lime		
3086	lime - Mississippi		

I certify this is a true and correct copy of the above mentioned well.

STATE OF KANSAS)
) ss.
SEDGWICK COUNTY)

D. T. Ingling

Subscribed and sworn to before me, a Notary Public, in said county and state.

PLUGGING
FILE SEC 11 T 19 R 3W
BOOK PAGE 38 LINE 12

M. E. Black
Notary Public

My commission expires: 2-27-60