


WELL PLUGGING RECORD

Give All Information Completely  
 Make Required Affidavit

COUNTY Kiowa SEC. 3 TWP. 30 s RGE. 18 w E/W  
 Location as in quarters or footage from lines:  
C NE SW

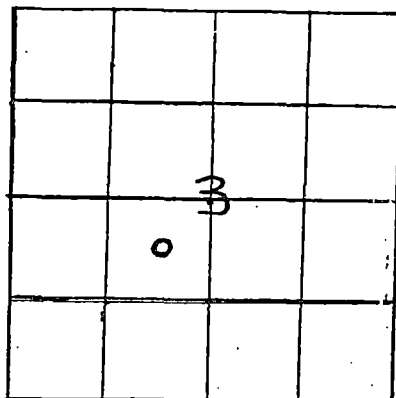

Lease Owner K & E Drilling, Inc.  
 Lease Name Parkin Well No. 6  
 Office Address Hardage Center, Suite 300, 100 S. Main - Wichita, 6720  
 Character of Well (Completed as Oil, Gas or Dry Hole): Gas  
 Date Well Completed 8/16/67  
 Application for plugging filed 7/9/82; approved 7/12/82  
 Plugging commenced 8-13-82  
 Plugging completed 8-19-82  
 Reason for abandonment of well or producing formation  
Depleted

Locate Well  
 correctly on above  
 Section Platt.

Was permission obtained from the Conservation Division or it's  
 Agent's before plugging was commenced? Yes

Name of Conservation Agent who supervised plugging of this well Steve Durrant  
 Producing formation Marmaton Depth to top 4748' bottom 4823' T.D. 5030'

Show depth and thickness of all water, oil and gas-formations.

OIL, GAS OR WATER RECORDS

Casing Record

Formation	Content	From	To	Size	Put in	Pulled Out
				8-5/8"	472'	None
				4-1/2"	5028'	1976'

Describe in detail the manner in which the well was plugged, indicating where the mud  
 fluid was placed and the method or methods used in introducing it into the hold. If cement  
 or other plugs were used, state the character of same and depth placed, from \_\_\_\_\_ feet  
 to \_\_\_\_\_ feet for each plug set.

Bottom was plugged off w/35 sx. 200# shut in pressure. Pulled 61 Jts. of 4 1/2", plugged  
well w/3 Hulla, 15 Gel, 100 Sx 50/50 Pos. 4% Gel, 3% CC. Maximum pressure 900 #, blew  
hole in the casing and stopped at that point.

Plugging Complete

(If additional description is necessary, use BACK of this sheet)

Name of Plugging Contractor Kelso Casing Pulling

STATE OF Kansas COUNTY OF Rice, ss.


R. Darrell Kelso (employee of owner) or (owner or operator) of the  
 above-described well, being first duly sworn on oath, says: That I have knowledge of the  
 facts, statements, and matters herein contained and the log of the above-described well as  
 filed and that the same are true and correct. So help me God.

(Signature) R. Darrell Kelso  
Box 347 Chase, Ks. 67524  
 (Address)

RECEIVED  
 STATE CORPORATION COMMISSION

SFP 09 1982 9-9-82

CONSERVATION AND  
 SUBSURFACE DIVISION  
 Wichita, Kansas

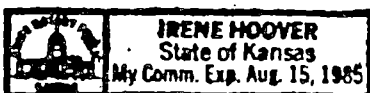

My Commission expires: \_\_\_\_\_

SWORN TO before me this 24th day of August, 1982  
Irene Hoover  
 Notary Public.

# DRILLER'S WELL LOG

OPERATOR: K & E DRILLING, INC.  
719 Union Center  
Wichita, Kansas 67202

WELL NAME: PARKIN #6  
LOCATION: C NE SW  
Sec. 3-30S-18W  
Kiowa County, Kansas

CONTRACTOR: **K&E DRILLING, INC.**  
719 UNION CENTER BLDG.  
WICHITA, KANSAS

COMMENCED: 8/2/67  
COMPLETED: 8/16/67  
ELEVATION: 2154' Gr.; 2160' DF;  
2163' KB  
PRODUCTION:

CASING RECORD:  
8-5/8" @ 472' w/300 sx.  
4 1/2" @ 5028' w/135 sx.  
ROTARY TOTAL DEPTH: 5030'

## FORMATION RECORD

*Depths shown indicate bottom of formations encountered.*

Clay & Shale	290
Sand	330
Shale	1045
Shale & Shells	1780
Shale	2075
Lime	2765
Lime & Shale	2892
Lime	3204
Shale & Lime	3369
Lime	3641
Lime & Shale	3777
Lime	5030

## CERTIFICATION

State of KANSAS }  
County of SEDGWICK } ss:

I, H. L. Wilson, of K&E DRILLING, INC., upon oath state that the above and foregoing is a true and correct copy of the Driller's Log of the above named well.

H. L. Wilson H. L. Wilson

Subscribed and sworn to before me this 23rd day of August, 1967.

Judie K. Eby  
Judie K. Eby Notary Public.

My Commission expires: 9-14-70

