

STATE OF KANSAS
STATE CORPORATION COMMISSION


Form CP-4

Give All Information Completely
Make Required Affidavit
Mail or Deliver Report to:
Conservation Division
State Corporation Commission

WELL PLUGGING RECORD

P. O. Box 17027
Wichita, Kansas 67217
NORTH

Kiowa County, Sec. 4 Twp. 30S Rge. (X) 18 (W)
Location as "NE/CNWxSWx" or footage from lines C SE/4
Lease Owner K&E Drilling, Inc.
Lease Name Parkin Well No. 3
Office Address 816 Union Center, Wichita, KS 67202
Character of Well (completed as Oil, Gas or Dry Hole) Gas
Date well completed October 14 1966
Application for plugging filed June 26 1978
Application for plugging approved June 27 1978
Plugging commenced September 1 1978
Plugging completed September 8 1978
Reason for abandonment of well or producing formation Depleted

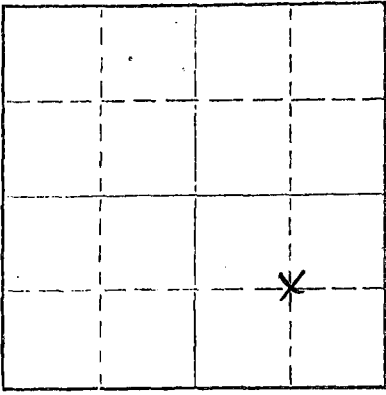

Locate well correctly on above
Section Plat

If a producing well is abandoned, date of last production May 1978
Was permission obtained from the Conservation Division or its agents before plugging was commenced? Yes

Name of Conservation Agent who supervised plugging of this well William T. Owen
Producing formation Mississippian Depth to top 4994' Bottom Total Depth of Well 5008 Feet
Show depth and thickness of all water, oil and gas formations.

OIL, GAS OR WATER RECORDS

CASING RECORD

FORMATION	CONTENT	FROM	TO	SIZE	PUT IN	PULLED OUT
				8-5/8"	560'	None
				5-1/2"	5002'	2644'

Describe in detail the manner in which the well was plugged, indicating where the mud fluid was placed and the method or methods used in introducing it into the hole. If cement or other plugs were used, state the character of same and depth placed, from feet to feet for each plug set.

Plugged back to 4995' with sand and spotted 5 sx. cement plug.
Set bridge at 520' and filled surface casing with ready-mix cement (8 yards) to base of collar

RECEIVED
STATE CORPORATION COMMISSION

SEP 15 1978 9-15-78

CONSERVATION DIVISION
Wichita, Kansas


(If additional description is necessary, use BACK of this sheet)
Name of Plugging Contractor Nicholas Casing Pulling
Address Box 373, Geneseo, Kansas 67444

STATE OF KANSAS, COUNTY OF SEDGWICK, ss.
Wayne L. Brinegar (employee of owner) or (owner) of the above-described

well, being first duly sworn on oath, says: That I have knowledge of the facts, statements, and matters herein contained and the log of the above-described well as filed and that the same are true and correct. So help me God.

(Signature) Wayne L. Brinegar
816 Union Center, Wichita, KS 67202
(Address)

SUBSCRIBED AND SWORN TO before me this 14th day of September, 1978

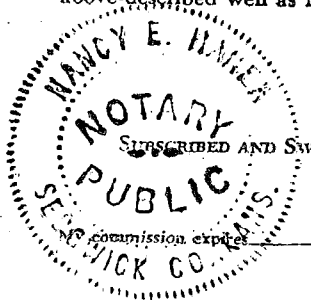

April 8, 1982
Nancy E. Haner
Notary Public.

DRILLER'S WELL LOG

OPERATOR: K & E DRILLING, INC.
719 Union Center
Wichita, Kansas

WELL NAME: Parkin Unit #3
LOCATION: Approx. C SE/4
Section 4-30S-18W
Kiowa County, Kansas

CONTRACTOR: **K & E DRILLING, INC.**
719 UNION CENTER BLDG.
WICHITA, KANSAS

COMMENCED: 9/23/66
COMPLETED: 10/9/66
ELEVATION: Gr. 2209'; DF 2215';
KB 2218'
PRODUCTION: Gas

CASING RECORD:

8-5/8" @560' w/ 300 sx. cement
5-1/2" @ 5002' w/100 sx. Salt Sat.

ROTARY TOTAL DEPTH: Pozmix w/12# gil. per sx.
5005'

FORMATION RECORD

Depths shown indicate bottom of formations encountered.

Shale & Shells	70
Sand	105
Shale & Shells	290
Shale	547
Anhydrite	560
Shale	1300
Shale & Shells	2112
Shale & Lime	2305
Lime	4124
Lime & Shale	4400
Lime	4970
Lime - Chert	5000
Lime	5005

RECEIVED
STATE CORPORATION COMMISSION
JUN 27 1978
CONSERVATION DIVISION
Wichita, Kansas

CERTIFICATION

State of KANSAS }
County of SEDGWICK } ss:

I, Wayne L. Brinegar, of K&E DRILLING, INC., upon oath state that the above and foregoing is a true and correct copy of the Driller's Log of the above named well.

Wayne L. Brinegar
Wayne L. Brinegar

Subscribed and sworn to before me this 17th day of October, 1966.

Judie K. Eby
Judie K. Eby Notary Public.

My Commission expires: 9-14-70

