

Give All Information Completely
Make Required Affidavit
Mail or Deliver Report to:
Conservation Division
State Corporation Commission
211 No. Broadway
Wichita, Kansas

WELL PLUGGING RECORD

Kiowa County, Sec. 7 Twp. 30S Rge. (E) 18 (W)

Location as "NE/CNW/SW" or footage from lines C-NE-SW

Lease Owner J. M. HUBER CORPORATION

Lease Name Kane Well No. 1

Office Address P. O. Box 12280 - 39th Station, Oklahoma City, Okla.

Character of Well (completed as Oil, Gas or Dry Hole) Dry Hole

Date well completed June 27, 1964

Application for plugging filed June 27, (verbal) 1964

Application for plugging approved June 27, 1964


Plugging commenced June 28, 1964

Plugging completed June 28, 10:00 A.M. 1964

Reason for abandonment of well or producing formation Dry Hole

If a producing well is abandoned, date of last production - 1964

Was permission obtained from the Conservation Division or its agents before plugging was commenced? Yes

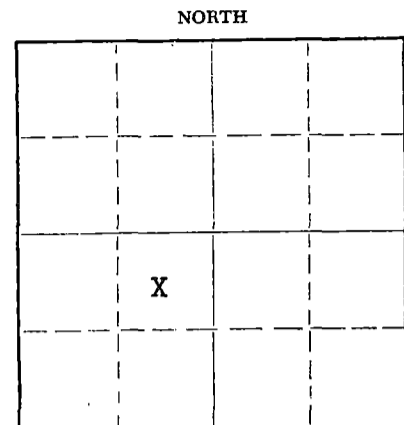

Locate well correctly on above Section Plat

Name of Conservation Agent who supervised plugging of this well Mr. A. V. Elving

Producing formation None Depth to top _____ Bottom _____ Total Depth of Well 5,159 Feet

Show depth and thickness of all water, oil and gas formations.

OIL, GAS OR WATER RECORDS

CASING RECORD

FORMATION	CONTENT	FROM	TO	SIZE	PUT IN	PULLED OUT
None				8 5/8	440	0

Describe in detail the manner in which the well was plugged, indicating where the mud fluid was placed and the method or methods used in introducing it into the hole. If cement or other plugs were used, state the character of same and depth placed, from _____ feet to _____ feet for each plug set.

Filled hole with mud, pushed plug with 1/4 sack hulls to 435'. Put in 25 sacks cement plug. Filled hole with mud to 40', pushed plug with 1/4 sack hulls to 40'. Cemented with 15 sacks cement.

RECEIVED
STATE CORPORATION COMMISSION

AUG 20 1964

CONSERVATION DIVISION
Wichita, Kansas

8-20-64

(If additional description is necessary, use BACK of this sheet)

Name of Plugging Contractor Bowers Drilling Company, Inc.
Address Union Center Building, Wichita, Kansas

STATE OF Oklahoma, COUNTY OF Oklahoma, ss.
Floyd L. Meade (employee of owner) or (owner or operator) of the above-described well, being first duly sworn on oath, says: That I have knowledge of the facts, statements, and matters herein contained and the log of the above-described well as filed and that the same are true and correct. So help me God.

(Signature) Floyd L. Meade

P. O. Box 12280-39th Station, Oklahoma City, Okla.
(Address)

SUBSCRIBED AND SWORN TO before me this 30th day of June, 1964

My commission expires March 7, 1967

Lydial M. Woods
Notary Public.



WELL LOG

COMPANY: J. M. Huber Corporation
 CONTRACTOR: Bowers Drilling Company, Inc.
 FARM: Kane No. 1
 LOCATION: C NE SW Section 7-30S-18W
 Kiowa County, Kansas
 COMMENCED: June 11, 1964
 COMPLETED: June 28, 1964
 ELEVATION: 2211 Ground

0 - 440	Redbed	Set 8-5/8" at 440' with 300 sacks
440 - 750	Redbed and shales	
750 - 1550	Shale and shells	
1550 - 2090	Shale	
2090 - 2875	Lime	
2875 - 2948	Lime and shale	
2948 - 3020	Lime	
3020 - 3079	Lime and shale	
3079 - 3142	Lime shells and shale	
3142 - 3780	Lime and shale	
3780 - 3895	Lime	
3895 - 4025	Lime and shale	
4025 - 4095	Lime	
4095 - 4555	Lime and shale	
4555 - 4625	Lime	
4625 - 4680	Lime and shale	
4680 - 5102	Lime	
5102 - 5159	Lime and chert	
5159	Total Depth	

RECEIVED
STATE CORPORATION COMMISSION

AUG 20 1964

CONSERVATION DIVISION
Wichita, Kansas

LOG TOPS:

Heebner	4176	Marmaton	4810
Brown Lime	4360	Cherokee	4935
Lansing	4382	Miss Chatt	4998
B/Kansas City	4797		

STATE OF KANSAS }
 COUNTY OF SEDGWICK } SS

I, Emil E. Bowers, do hereby certify that the above and foregoing is a true and correct copy of the copy of the log of the Kane No. 1 located C NE SW Section 7-30S-18W, Kiowa County, Kansas, as reflected by the files of Bowers Drilling Company, Inc.

Emil E. Bowers

Subscribed and sworn to before me, a Notary Public in and for Sedgwick County, Kansas, this 1st day of July, 1964.

Donna F. Miller
 Donna F. Miller, Notary Public

My commission expires May 1, 1966