


STATE OF KANSAS
STATE CORPORATION COMMISSION

WELL PLUGGING RECORD

Give All Information Completely
Make Required Affidavit
Mail or Deliver Report to:
Conservation Division
State Corporation Commission
211 No. Broadway
Wichita, Kansas

NORTH

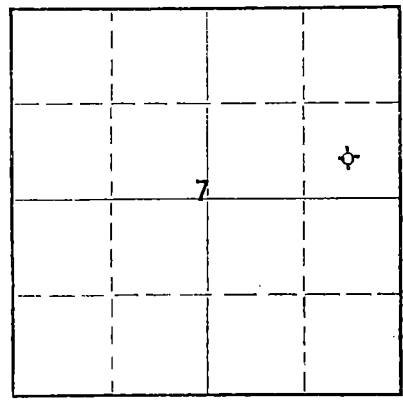

Locate well correctly on above Section Plat

Kiowa County. Sec. 7 Twp. 30S Rge. 18 (W)
Location as "NE/CNW/SW" or footage from lines C SE/4 NE/4
Lease Owner Graham-Michaelis Drilling, Inc.
Lease Name Parkin Well No. 1-7
Office Address 211 North Broadway, Wichita, Kansas 67202
Character of Well (completed as Oil, Gas or Dry Hole) Dry Hole
Date well completed October 4, 19 67
Application for plugging filed October 5, 19 67
Application for plugging approved (verbal) October 4, 19 67
Plugging commenced October 4, 19 67
Plugging completed October 4, 19 67
Reason for abandonment of well or producing formation _____

If a producing well is abandoned, date of last production _____ 19____
Was permission obtained from the Conservation Division or its agents before plugging was commenced? Yes

Name of Conservation Agent who supervised plugging of this well Archie V. Elving, Box 248, Pratt, Kansas
Producing formation none Depth to top _____ Bottom _____ Total Depth of Well 5070 Feet
Show depth and thickness of all water, oil and gas formations.

OIL, GAS OR WATER RECORDS

CASING RECORD

FORMATION	CONTENT	FROM	TO	SIZE	PUT IN	PULLED OUT
				8 5/8"	429'	none

Describe in detail the manner in which the well was plugged, indicating where the mud fluid was placed and the method or methods used in introducing it into the hole. If cement or other plugs were used, state the character of same and depth placed, from _____ feet to _____ feet for each plug set.

Filled well with heavy drilling mud, 25 sacks cement at 400', filled with heavy drilling mud and 15 sax cement at 45'.

RECEIVED
STATE CORPORATION COMMISSION

OCT 12 1967

10-12-67
CONSERVATION DIVISION
WICHITA, KANSAS

(If additional description is necessary, use BACK of this sheet)

Name of Plugging Contractor Graham-Michaelis Drilling, Inc.
Address 211 North Broadway, Wichita, Kansas 67202

STATE OF Kansas, COUNTY OF Sedgwick, ss.
John L. James (employee of owner) or (owner or operator) of the above-described well, being first duly sworn on oath, says: That I have knowledge of the facts, statements, and matters herein contained and the log of the above-described well as filed and that the same are true and correct. So help me God.

(Signature) John L. James
211 North Broadway, Wichita, Kansas 67202
(Address)

Subscribed and sworn to before me this 5th day of October, 19 67



Evelyn D. Evans
Notary Public.

PARKIN NO. 1-7

WELL RECORD:

LOCATION:

C SE NE Section 7-30S-18W
 Kiowa County, Kansas

Commenced: 9-21-67
 Completed: 10-5-67
 (Rotary)

CONTRACTOR:

Graham-Michaelis Drilling, Inc.
 Liberal Division
 P. O. Box 1294
 Liberal, Kansas 67901

CASING RECORD:

14 Joints 8-5/8" 24# Casing Set
 at 429' - Cemented w/325 sx HA-5
 Common

LOG

Surface Sand, Gyp & Red Bed	0 - 395
Red Bed & Anhy	395 - 1207
Red Bed & Shale	1207 - 1662
Red Bed & Gyp	1662 - 2318
Lime & Shale	2318 - 5070

5070' - Total Rotary Depth

The undersigned, Graham-Michaelis Drilling, Inc., Liberal Division, certifies that the above log is a true and correct copy of the formations encountered in drilling the above mentioned well, as taken from the Daily Drilling Report.

GRAHAM-MICHAELIS DRILLING, INC.
 LIBERAL DIVISION

By 
 H. R. Michaelis

HRM/rw

RECEIVED
 STATE CORPORATION COMMISSION

OCT 12 1967

CONSERVATION DIVISION
 Wichita, Kansas