


STATE OF KANSAS
STATE CORPORATION COMMISSION

Form CP-4

Give All Information Completely
Make Required Affidavit
Mail or Deliver Report to:
Conservation Division
State Corporation Commission
212 No. Market
Wichita, Kansas 67202
NORTH

WELL PLUGGING RECORD

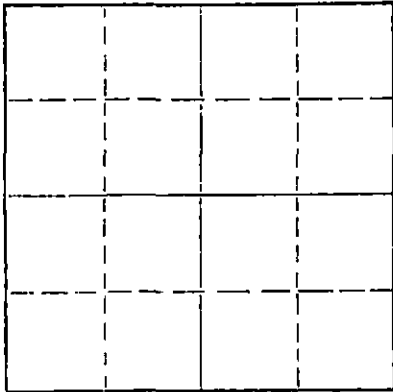

Locate well correctly on above
Section Plat

Location as "NE/CNWxSWx" or footage from lines KIOWA County. Sec 24 Twp. 30S Rge. (E)18 (W)
Location as "NE/CNWxSWx" or footage from lines C NW NE
Lease Owner ATLANTIC - RICHFIELD
Lease Name FLORENCE VIEUX Well No. 1
Office Address 3535 NW 58TH - OKLAHOMA CITY, OKLAHOMA
Character of Well (completed as Oil, Gas or Dry Hole) GAS
Date well completed _____ 19____
Application for plugging filed MARCH 4 1970
Application for plugging approved MARCH 5 1970
Plugging commenced MARCH 9 1970
Plugging completed MARCH 23 1970
Reason for abandonment of well or producing formation DEPLETED

If a producing well is abandoned, date of last production _____ 19____
Was permission obtained from the Conservation Division or its agents before plugging was commenced? YES

Name of Conservation Agent who supervised plugging of this well G. R. BIBERSTEIN
Producing formation _____ Depth to top _____ Bottom _____ Total Depth of Well 5084' Feet
Show depth and thickness of all water, oil and gas formations.

OIL, GAS OR WATER RECORDS

CASING RECORD

FORMATION	CONTENT	FROM	TO	SIZE	PUT IN	PULLED OUT
				8 5/8"	1137'	NONE
				5 1/2"	5084'	4426.90'

Describe in detail the manner in which the well was plugged, indicating where the mud fluid was placed and the method or methods used in introducing it into the hole. If cement or other plugs were used, state the character of same and depth placed, from _____ feet to _____ feet for each plug set.

5084' - 5076' - PLUG
5076' - 5030' - SAND
5030' - 4990' - 5 SACKS CEMENT
4990' - 425' - MUD
425' - 415' - ROCK BRIDGE
415' - 340' - 25 SACKS CEMENT
340' - 40' - MUD
40' - 30' - ROCK BRIDGE
30' - BASE - 10 SACKS CEMENT

RECEIVED
STATE CORPORATION COMMISSION
APR 16 1970
CONSERVATION DIVISION
Wichita, Kansas

(If additional description is necessary, use BACK of this sheet)
Name of Plugging Contractor SANTA-FE PIPE & SUPPLY, INC.
Address BOX 562 - GREAT BEND, KANSAS

STATE OF KANSAS COUNTY OF BARTON, ss.
T. L. Nutt (employee of owner) or (~~owner~~) of the above-described well, being first duly sworn on oath, says: That I have knowledge of the facts, statements, and matters herein contained and the log of the above-described well as filed and that the same are true and correct. So help me God.

(Signature) [Signature]
BOX 562 - GREAT BEND, KANSAS
(Address)

SUBSCRIBED AND SWORN TO before me this: 14th day of APRIL, 1970

My commission expires JULY 31, 1970
Mary M. Guesnier
Mary M. Guesnier Notary Public.

15-097-30129-0000

CLIENT: Sinclair Oil & Gas Company
50 Executive Building
2309 W Expressway
Oklahoma City, Oklahoma 73112

LOCATION: 660' from North &
West Lines of the
NE/4
Sec. 24-30E-18N
Nowa County, Kansas

DRILLER: German Drilling Company
302 Petroleum Building
Wichita, Kansas 67202

RECEIVED
STATE CORPORATION COMMISSION
MAR 5 1970
CONSERVATION DIVISION
Wichita, Kansas

Well: View
Date Commenced: 4-11-66
Date Completed: 5-14-66

Well No. 1

Depth	Feet	Formation
0	75	Sand
75	275	Red Red
275	375	Red Red
375	420	Shale
420	552	Clay-Shale
552	580	Lime-Shell-Shale
580	703	Shale
703	938	Shale-Shells
938	1025	Shale
1025	1126	St. Coral
1126	1150	Shale
1150	1855	Shale
1855	2193	Shale & Shells
2193	2357	Shale & Limestone
2357	2475	Shale & Lime
2475	2545	Lime
2545	2640	Lime-Shale
2640	3107	Lime
3107	3185	Shale & Lime
3185	3390	Lime & Shale
3390	3525	Lime-Chalky
3525	3941	Shale-Lime
3941	4440	Lime & Shale
4440	4492	HC Lime Stone
4492	TD	Lime

I hereby certify that the foregoing is a true and correct copy of the Well Log for the Florence View # 1, drilled for Sinclair Oil & Gas Company, and completed May 14, 1966.

GERMAN DRILLING COMPANY

Harvey V. German
Harvey V. German - Owner

STATE OF KANSAS)
COUNTY OF SEDGEMAN) ss.

Subscribed and sworn to, before the undersigned, A Notary Public, in and for County and State aforesaid, this 27th day of May, 1966.

Carroll H. German
Carroll H. German - Notary Public

My Commission expires February 28, 1969.