


STATE OF KANSAS
STATE CORPORATION COMMISSION

WELL PLUGGING RECORD

Give All Information Completely
Make Required Affidavit
Mail or Deliver Report to
Conservation Division
State Corporation Comm.
245 North Water
Wichita, KS 67202

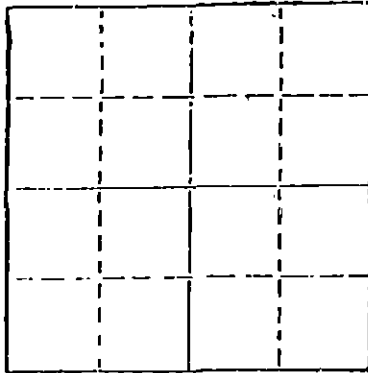

Locate well correctly on above
Section Plat

Barton County. Sec. 31 Twp. 20S Rge. 13W E/W
Location as "NE/CNW $\frac{1}{4}$ SW $\frac{1}{4}$ " or footage from lines
SE SW SW

Lease Owner Brougner Oil, Inc.
Lease Name Morris (SWD) Well No.
Office Address Drawer 1367, Great Bend, Ks. 67530
Character of Well (Completed as Oil, Gas or Dry Hole)

Date Well completed 19
Application for plugging filed 19
Application for plugging approved 19
Plugging commenced 9/22/80 19
Plugging completed 9/22/80 19
Reason for abandonment of well or producing formation

Depleted

If a producing well is abandoned, date of last production 19

Was permission obtained from the Conservation Division or
its agents before plugging was commenced? Yes

Name of Conservation Agent who supervised plugging of this well D. Rankin
Producing formation Depth to top Bottom Total Depth of Well 3600'
Show depth and thickness of all water, oil and gas formations.

OIL, GAS OR WATER RECORDS

CASING RECORD

FORMATION	CONTENT	FROM	TO	SIZE	PUT IN	PULLED OUT
				8-5/8"	227	None
				4 1/2"	3599	2222 230'

Describe in detail the manner in which the well was plugged, indicating where the mud fluid
was placed and the method or methods used in introducing it into the hold. If cement or other
plugs were used, state the character of same and depth placed, from feet to
feet for each plug set.

Pumped 2 sacks hulls, 50 sacks cement, 2 sacks hulls, 20 sacks gel. Ran tubing
to 220' and circulated 70 sacks cement.


Plugging complete.

RECEIVED
STATE CORPORATION COMMISSION
SEP 26 1980
CONSERVATION DIVISION
Wichita, Kansas

(If additional description is necessary, use BACK of this report)
Name of Plugging Contractor KELSO CASING PULLING
CHASE, KANSAS

STATE OF Kansas COUNTY OF Rice ss.
R. Darrell Kelso (employee of owner) or (owner or operator)
of the above-described well, being first duly sworn on oath, says: That I have knowledge of
the facts, statements, and matters herein contained and the log of the above-described well
as filed and that the same are true and correct. So help me God.

(Signature)

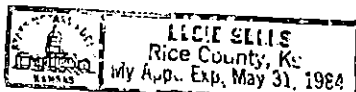

SUBSCRIBED AND SWORN TO before me this 23rd day of September, 19 80

(Address)

Notary Public.

My commission expires MAY 31-1984