


WELL PLUGGING RECORD

Give All Information Completely
Make Required Affidavit
Mail or Deliver Report to:
Conservation Division
State Corporation Commission
800 Bitting Building
Wichita, Kansas

BARTON County. Sec. 31 Twp 20 Rge. (E) 13 (W)
Location as "NE/CNW%SW%" or footage from lines NE NW NE
Lease Owner WILLIAM GRAHAM OIL CO.
Lease Name HISS Well No. 4
Office Address P.O. BOX 1033, WICHITA, KANSAS
Character of Well (completed as Oil, Gas or Dry Hole) DRY HOLE
Date well completed APRIL 9, 1954 19
Application for plugging filed APRIL 9, 1954 (Verbal) 19
Application for plugging approved APRIL 9, 1954 (Verbal) 19
Plugging commenced APRIL 9, 1954 19
Plugging completed APRIL 9, 1954 19
Reason for abandonment of well or producing formation _____

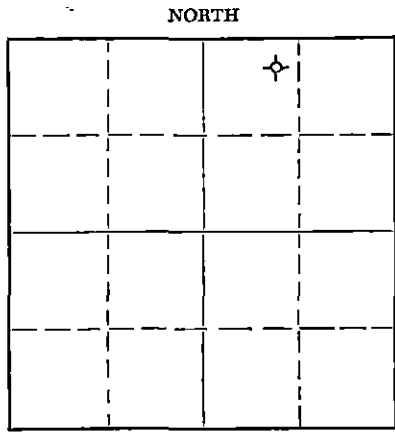

Locate well correctly on above
Section Plat

If a producing well is abandoned, date of last production _____ 19
Was permission obtained from the Conservation Division or its agents before plugging was commenced? YES

Name of Conservation Agent who supervised plugging of this well WARREN H. HORNER, BOX 207, GREAT BEND, KANSAS
Producing formation _____ Depth to top _____ Bottom _____ Total Depth of Well 3425' Feet
Show depth and thickness of all water, oil and gas formations.

OIL, GAS OR WATER RECORDS

CASING RECORD

FORMATION	CONTENT	FROM	TO	SIZE	PUT IN	PULLED OUT
				8 5/8"	200'	None

Describe in detail the manner in which the well was plugged, indicating where the mud fluid was placed and the method or methods used in introducing it into the hole. If cement or other plugs were used, state the character of same and depth placed, from _____ feet to _____ feet for each plug set.

SET BRIDGE AT 200' W/20 SACKS
CEMENT, FILLED WITH MUD TO 35'
AND SET BRIDGE WITH 10 SACKS
CEMENT, MUD TO SURFACE.

RECEIVED
STATE CORPORATION COMMISSION
4-27-54 APR 27 1954
CONSERVATION DIVISION
Wichita, Kansas

(If additional description is necessary, use BACK of this sheet)
Name of Plugging Contractor GARVEY DRILLING COMPANY
Address 305 EAST THIRD STREET WICHITA, KANSAS

STATE OF KANSAS, COUNTY OF SEDGWICK, ss.
J. A. GILLILAND (employee of owner) or (Notary Public) of the above-described well, being first duly sworn on oath, says: That I have knowledge of the facts, statements, and matters herein contained and the log of the above-described well as filed and that the same are true and correct. So help me God.

(Signature) J. A. Gilliland
1005 EAST SECOND STREET - WICHITA, KANS.
(Address)

SUBSCRIBED AND SWORN TO before me this 27 day of APRIL, 1954

My commission expires SEPTEMBER 14, 1957 Notary Public.

24-7368-S 3-53-20M

PLUGGING
FILE SEC 31 TWP 20 R 13W
BOOK PAGE 26 LINE 13

GMR
File Copy

WELL LOG

15.009.05722.0000

COMPANY William Graham Company

BEC. 31 T. 20 R. 13W

FARM Hiss

NO. 4

LOC. NW NE NE


TOTAL DEPTH 3425'

COUNTY Barton County, Kansas

COMM. April 1, 1954

COMP. April 9, 1954

CONTRACTOR Garvey Drilling Company

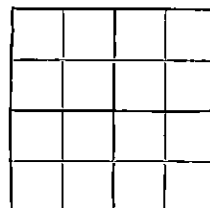

CASING 8-5/8" @ 200' w/175 sax.

ELEVATION

PRODUCTION D & A

FIGURES INDICATE BOTTOM OF FORMATIONS

75	Sand
113	Coarse Sand
200	Hard Sand
320	Shale
765	Red Bed
790	Anhydrite
1625	Shale & Shells
2973	Lime & Shale
3015	Lime
3158	Lime & Shale
3425	Lime
3425	R.T.D.

RECEIVED
 STATE CORPORATION COMMISSION
 APR 27 1954
 CONSERVATION DIVISION
 Wichita, Kansas

State of KANSAS

County of SEDGWICK

SS:

I, W. W. Fisher of Garvey Drilling Company

upon oath state that the above and foregoing is a true and correct copy of the log of the HISS #4 well.

W W Fisher

Subscribed and sworn to before me this 15th day of April 19 54

My Commission Expires: October 13, 1954

PLUGGING
 FILE SEC 31 T 20 R 13W
 PAGE 26 LINE 13

NOTARY PUBLIC

Walter H. Hedman