


WELL PLUGGING RECORD

Give All Information Completely  
Make Required Affidavit  
Mail or Deliver Report to:  
Conservation Division  
State Corporation Commission  
212 North Market, Insurance Bldg.  
Wichita, Kansas

Barton County, Sec. 31 Twp. 20 Rge. (E) 13 (W) SW SE SW

T - 20 NORTH R - 13W

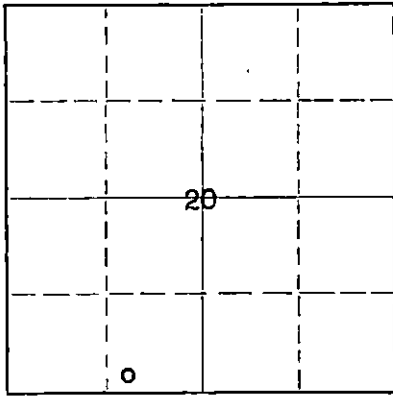

Locate well correctly on above Section Plat

Location as "NE/CNW/SW" or footage from lines \_\_\_\_\_  
Lease Owner Frank J. Black  
Lease Name Benjamin Well No. 4  
Office Address McPherson, Kansas  
Character of Well (completed as Oil, Gas or Dry Hole) Oil  
Date well completed 3-1 1951  
Application for plugging filed 6-29-61 1961  
Application for plugging approved 7-7 1961  
Plugging commenced 7-13 1961  
Plugging completed 7-18 1961  
Reason for abandonment of well or producing formation Non-commercial

If a producing well is abandoned, date of last production \_\_\_\_\_ 19\_\_\_\_  
Was permission obtained from the Conservation Division or its agents before plugging was commenced? Yes

Name of Conservation Agent who supervised plugging of this well ~~FRANK J. BLACK~~ DONALD TRUAN  
Producing formation \_\_\_\_\_ Depth to top \_\_\_\_\_ Bottom \_\_\_\_\_ Total Depth of Well 3602 Feet  
Show depth and thickness of all water, oil and gas formations.

OIL, GAS OR WATER RECORDS

CASING RECORD

FORMATION	CONTENT	FROM	TO	SIZE	PUT IN	PULLED OUT
				8 5/8	222'	None
				5 1/2	360'	2720'

Describe in detail the manner in which the well was plugged, indicating where the mud fluid was placed and the method or methods used in introducing it into the hole. If cement or other plugs were used, state the character of same and depth placed, from \_\_\_\_\_ feet to \_\_\_\_\_ feet for each plug set.

Plug @ 3375  
Top Perforation 3344

Sanded to 3330' - dumped 5 sks cement - pulled casing -  
pumped in 10 sks mud and 80 sks cement - removed swedge  
from surface pipe - dumped 5sks cement to base of cellar

RECEIVED  
STATE CORPORATION COMMISSION

AUG 8 1961

CONSERVATION DIVISION  
Wichita, Kansas

Name of Plugging Contractor R & D Casing Pulling Co License # 236  
Address Box # 572, Hutchinson, Kansas

STATE OF KANSAS, COUNTY OF MCPHERSON, ss.  
Frank J. Black (landowner or owner) of the above-described well, being first duly sworn on oath, says: That I have knowledge of the facts, statements, and matters herein contained and the log of the above-described well as filed and that the same are true and correct. So help me God.

(Signature) Frank J. Black  
(Address) \_\_\_\_\_

SUBSCRIBED AND SWORN to before me this 7th day of August, 1961

My commission expires July 16, 1963

Jerry Pelizman  
JERRY PELIZMAN Notary Public.

KANSAS WELL LOG BUREAU --- KANSAS GEOLOGICAL SOCIETY  
508 EAST MURDOCK - WICHITA, KANSAS

COPY

COMPANY PETROLEUM, INC.

SEC. 31 T. 20 R. 13 W  
COR. SW SE SW

FARM Benjamin "A"

NO. 4

TOTAL DEPTH 3602'

COMM. 2-19-51


COMP. 3-1-51

COUNTY Barton  
KANSAS

SHOT OR TREATED

CONTRACTOR Garvey Oil

ISSUED 5-5-51

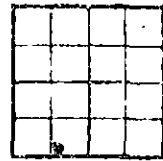

## CASING

8-5/8" 222'  
5 1/2" 3601'

ELEVATION 1916 K. B.

PRODUCTION IPP 32 bbls. &amp; no wtr.

FIGURES INDICATE BOTTOM OF FORMATIONS

Sandy Clay	15
Soft Sand	205
Shale	222
Sand	334
Red Bed & Sand	782
Anhydrite	818
Shale & Shells	1330
Salt & Shale	1500
Shale & Shells	1650
Lime & Shale	1770
Brown Lime	1915
Lime	2140
Shale & Shells	2210
Shale	2335
Shale & Shells	2675
Lime & Shale	2705
Lime	3159
Shale & Lime	3310
Lime	3596
Arbuckle Lime	3602 R. T. D.
Total Depth	

## Tops:

Heebner	3173
Toronto	3190
Brown Lime	3287
Lansing	3299
B. K. C.	3511
Arbuckle	3551

RECEIVED  
STATE CORPORATION COMMISSION

JUL 5 1961

CONSERVATION DIVISION  
Wichita, Kansas