


STATE OF KANSAS
STATE CORPORATION COMMISSION

Form CP-4

Give All Information Completely
Make Required Affidavit
Mail or Deliver Report to:
Conservation Division
State Corporation Commission
212 No. Market
Wichita, Kansas 67202

WELL PLUGGING RECORD

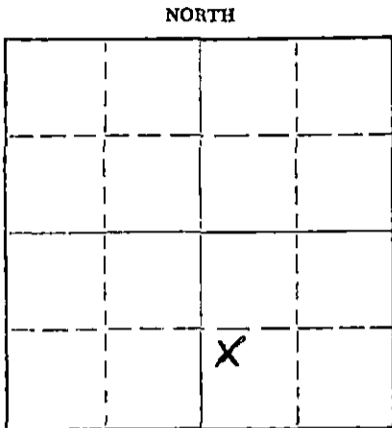

Locate well correctly on above
Section Plat

Barton County, Sec. 31 Twp. 20 Rge. 13 (E) W (W)
Location as "NE/CNW/SW" or footage from lines NW SW SE
Lease Owner Joe Brougher Oil Co.
Lease Name Benjamin 'B' Well No. # 1
Office Address 5513 Apache ; Great Bend, Kansas 67530
Character of Well (completed as Oil, Gas or Dry Hole) _____
Date well completed _____ 19____
Application for plugging filed November 19 70
Application for plugging approved November 19 70
Plugging commenced November 10 19 70
Plugging completed November 14 19 70
Reason for abandonment of well or producing formation _____

If a producing well is abandoned, date of last production _____ 19____
Was permission obtained from the Conservation Division or its agents before plugging was commenced? Yes

Name of Conservation Agent who supervised plugging of this well Don Truan
Producing formation _____ Depth to top _____ Bottom _____ Total Depth of Well _____ Feet
Show depth and thickness of all water, oil and gas formations.

OIL, GAS OR WATER RECORDS

CASING RECORD

FORMATION	CONTENT	TO	SIZE	PUT IN	PULLED OUT
	RECEIVED STATE CORPORATION COMMISSION DEC 8 - 1970 CONSERVATION DIVISION Wichita, Kansas		8 5/8"	220	None
			5 1/2"	3591	2840

Describe in detail the manner in which the well was plugged, indicating where the mud fluid was placed and the method or methods used in introducing it into the hole. If cement or other plugs were used, state the character of same and depth placed, from _____ feet to _____ feet for each plug set.

November 10, 1970 Plugged off bottom. Dumped sand to 3000'. Mixed and dumped 5 sx of cement to 2960'.

November 14, 1970 Plugged off top. Globe Oil Well Cementing Co. mixed and pumped down 8 5/8" surface casing: 3 sx hulls, 20 sx gel, released plug, mixed and pumped 100 sx of cement.

(If additional description is necessary, use BACK of this sheet)


Name of Plugging Contractor RUSS CASING PULLING, INC.
Address P. O. Box 1082 ; Great Bend, Kansas 67530

STATE OF Kansas, COUNTY OF Barton, ss.
Joe Brougher (employee of owner) or (owner or operator) of the above-described well, being first duly sworn on oath, says: That I have knowledge of the facts, statements, and matters herein contained and the log of the above-described well as filed and that the same are true and correct. So help me God.

(Signature) Joe Brougher
5513 Apache Road, Great Bend, Kansas
(Address)

SUBSCRIBED AND SWORN to before me this 7th day of December, 1970

My commission expires July 23rd, 1974.
Joann Skolaut
Notary Public.

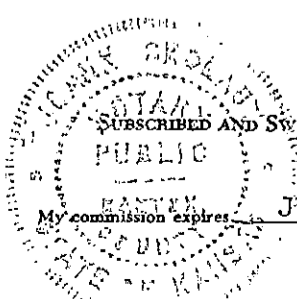

KANSAS GEOLOGICAL SOCIETY
 KANSAS WELL LOG BUREAU - KANSAS WELL SAMPLE BUREAU
 KANSAS GEOLOGICAL SOCIETY BUILDING
 508 EAST MURDOCK - WICHITA, KANSAS

15.009.15938.0000

COMPANY **PETROLEUM, INC.**

SEC. **31 20 13W**
 NW SW SE R.
 LOG.


FARM **Benjamin "B"**

NO. **1**

Darton

COUNTY

KANSAS

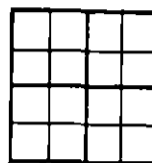

TOTAL DEPTH **3607'**
 COMM. **12-20-50**
 SHOT OR TREATED
 CONTRACTOR **Garvey Oil Co.**
 ISSUED **3-3-51**

COMP. **1-2-51**

CASING

20	10	
15	5/8	250'
12	6	
13	5 1/2	3606'

ELEVATION **1912 DF**

PRODUCTION **29 NO & RW**

FIGURES INDICATE BOTTOM OF FORMATIONS

surface clay	50
sand-shale	240
shale-shells	-250
sand	310
sand, clay	335
red bed	796
anhydrite	820
shale-shells	1150
shale, lime	1725
lime	1835
lime, shale	1970
shale	2375
shale, shells	2675
lime, shale	2900
lime	3119
shale	3201
lime	3607
Total Depth	

TOPS:

Heebner	3178
Toronto	3197
B. Cread	3215
Brown lime	3291
Lansing	3303
B/Kansas City	3516
Arbuckle	3557

WICHITA, KANSAS