

STATE OF KANSAS
STATE CORPORATION COMMISSION

Form CP-4


Give All Information Completely
Make Required Affidavit
Mail or Deliver Report to:
Conservation Division
State Corporation Commission
212 No. Market
Wichita, Kansas

WELL PLUGGING RECORD

BARTON County. Sec. 31 Twp. 20s Rge. 13 (X) (W)

Location as "NE/CNWxSWx" or footage from lines. SW NW SW
Lease Owner: PETROLEUM, INC.,
Lease Name: BENJAMIN Well No. 8
Office Address: R.R. #2, GREAT BEND, KANSAS
Character of Well (completed as Oil, Gas or Dry Hole) DRY HOLE
Date well completed FEBRUARY 17 19 67
Application for plugging filed FEBRUARY 17 19 67
Application for plugging approved FEBRUARY 17 19 67
Plugging commenced FEBRUARY 17 19 67
Plugging completed FEBRUARY 17 19 67
Reason for abandonment of well or producing formation NO PRODUCIBLE ZONE

NORTH

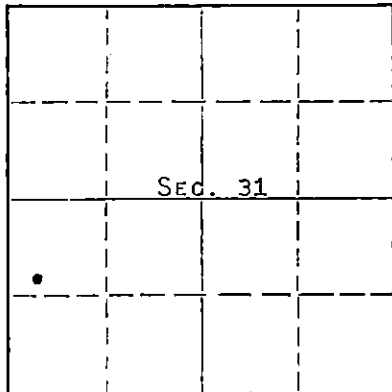

Locate well correctly on above
Section Plat

If a producing well is abandoned, date of last production NONE 19
Was permission obtained from the Conservation Division or its agents before plugging was commenced?

Name of Conservation Agent who supervised plugging of this well DONALD TRUAN
Producing formation _____ Depth to top _____ Bottom _____ Total Depth of Well 3614 Feet
Show depth and thickness of all water, oil and gas formations.

OIL, GAS OR WATER RECORDS

CASING RECORD

FORMATION	CONTENT	FROM	TO	SIZE	PUT IN	PULLED OUT
				8-5/8"	384'	NONE

Describe in detail the manner in which the well was plugged, indicating where the mud fluid was placed and the method or methods used in introducing it into the hole. If cement or other plugs were used, state the character of same and depth placed, from _____ feet to _____ feet for each plug set.

MUD TO 370', FOLLOWED BY WOODEN PLUG, PLACED 20 SACKS CEMENT ON TOP OF PLUG.
MUD TO 40', FOLLOWED BY WOODEN PLUG, PLACED 1/4 SACK HULLS AND 10 SACKS CEMENT ON TOP OF PLUG TO BASE OF WELL CELLAR.

RECEIVED
FEB 27 1967
KANSAS STATE CORPORATION COMMISSION

(If additional description is necessary, use BACK of this sheet)

Name of Plugging Contractor GARVEY DRILLING CO.
Address R.R. #2, GREAT BEND, KANSAS

STATE OF KANSAS, COUNTY OF BARTON, ss.
MONTE CHADD (employee of owner) or (owner/operator) of the above-described well, being first duly sworn on oath, says: That I have knowledge of the facts, statements, and matters herein contained and the log of the above-described well as filed and that the same are true and correct. So help me God. MONTE CHADD, DIST. PROD. SUPT.

(Signature) *Monte Chadd*
R.R. #2, GREAT BEND, KANSAS
(Address)

SUBSCRIBED AND SWORN to before me this 24 day of FEBRUARY, 19 67

Richard M. Dumbler
Notary Public.

My commission expires MAY 28, 1969

WELL LOG

COMPANY Petroleum, Inc.

BEG. 31 T. 20S R. 13W

FARM Benjamin

NO. 8

LOG. SW NW SW


TOTAL DEPTH 3614'

COUNTY Barton

COMM. 2-11-67

COMP. 2-17-67

CONTRACTOR Garvey Drilling Company

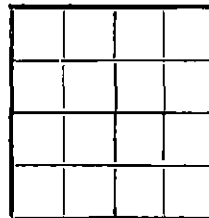

CASING 8 5/8" @ 384' w/325 sx

ELEVATION 1912' DF

PRODUCTION D & A

FIGURES INDICATE BOTTOM OF FORMATIONS

- 217' Sand
- 325' Shale and Shells
- 775' Red Bed
- 820' Anhydrite
- 1255' Sand and Shale
- 1592' Shale
- 1965' Shale with Lime
- 2110' Lime with Shale
- 2125' Shale
- 2440' Shale and Shells
- 2715' Shale with Lime
- 2740' Lime
- 2830' Lime and Shale
- 3000' Shale with Lime
- 3565' Lime with Shale
- 3575' Lime
- 3595' Conglomerate and Lime
- 3614' Shale
- 3614' RTD

RECEIVED
 STATE CORPORATION COMMISSION
 FEB 27 1967
 CONSERVATION DIVISION
 Wichita, Kansas

State of Kansas }
 County of Barton } SS

I, Sam N. Stephens of Garvey Drilling Company

upon oath state the above and foregoing is a true and correct copy of the log of the Benjamin No. 8 well.

Sam N. Stephens

Subscribed and sworn to before me this 23rd day of February 19 67

My Commission Expires: November 5th, 1969

Richard S. Doy
 NOTARY PUBLIC