

D


STATE OF KANSAS
STATE CORPORATION COMMISSION

Form CP-4

Give All Information Completely
Make Required Affidavit
Mail or Deliver Report to:
Conservation Division
State Corporation Commission
212 No. Market
Wichita, Kansas

WELL PLUGGING RECORD

NORTH

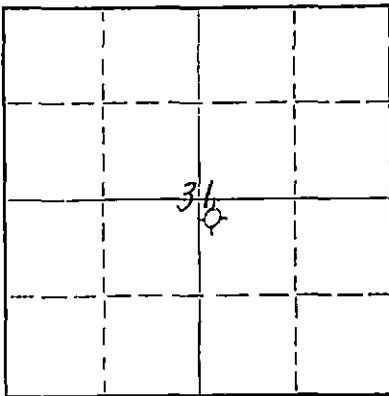

Locate well correctly on above
Section Plat

Barton County. Sec. 31 Twp. 20 Rge. (E) 13 (W)
Location as "NE/CNW/SW" or footage from lines NW NW SE
Lease Owner Aspen Drilling Co., & Dean & Clark
Lease Name Benjamin Well No. 2
Office Address Box 783, Great Bend, Kansas
Character of Well (completed as Oil, Gas or Dry Hole) dry hole
Date well completed 9-3-66 19
Application for plugging filed 9-6-66 19 66
Application for plugging approved 19
Plugging commenced 9-3-66 19
Plugging completed 9-3-66 19
Reason for abandonment of well or producing formation dry hole

If a producing well is abandoned, date of last production 19
Was permission obtained from the Conservation Division or its agents before plugging was commenced? yes

Name of Conservation Agent who supervised plugging of this well Don Truan
Producing formation _____ Depth to top _____ Bottom _____ Total Depth of Well _____ Feet
Show depth and thickness of all water, oil and gas formations.

OIL, GAS OR WATER RECORDS

CASING RECORD

FORMATION	CONTENT	FROM	TO	SIZE	PUT IN	PULLED OUT
		0	250"	8 5/8"	250'	none

Describe in detail the manner in which the well was plugged, indicating where the mud fluid was placed and the method or methods used in introducing it into the hole. If cement or other plugs were used, state the character of same and depth placed, from _____ feet to _____ feet for each plug set.

Bottom plug @ 240' with 1/4 sack huls & 25 sx thru drill pipe.
Top plug @ 40' w/1/2 sack huls, 15 sx cement.

RECEIVED
SEP 19 1966
CONSERVATION DIVISION
Wichita, Kansas

(If additional description is necessary, use BACK of this sheet)

Name of Plugging Contractor Aspen Drilling Co.
Address Box 783, Great Bend, Kansas

STATE OF Kansas, COUNTY OF Barton, ss.
William S. Schachle (employee of owner) or (owner or operator) of the above-described

well, being first duly sworn on oath, says: That I have knowledge of the facts, statements, and matters herein contained and the log of the above-described well as filed and that the same are true and correct. So help me, God.

(Signature) William S. SchachleBox 783, Great Bend, Kansas

(Address)

SUBSCRIBED AND SWORN to before me this 6th day of September, 19 66My commission expires August 27, 1969Delores Strecker

Notary Public.

D R I L L E R S L O G

COMPANY Aspen Drilling Co., & Dean & Clark
 CONTRACTOR Aspen Drilling Co.
 LEASE NAME Benjamin #2
 LOCATION NW NW SE Sec. 31-T20S-R13W
 Barton County, Kansas
 ELEVATION 1909 K. B.
 SURFACE PIPE 12 jts. (242) 8 5/8"
 COMMENCED 8-26-66
 COMPLETED 9-3-66
 ROTARY TOTAL DEPTH 3660'

<u>FORMATION</u>	<u>DEPTH</u>	
Clay & Sandstone	160	Spudded in 12 1/4" hole @ 2 P.M.
Sandstone & Shale	252	Drilled 12 1/4" hole to 252'.
Dakota Sandstone	310	Ran 12 jts. 242' used 8 5/8" @
Shale, Shells, Red		250', cemented with 250 sx sunset
Bed	440	w/2% gel. Plug down @ 8:45 P.M.
Red Bed	785	Cement did circulate.
Anhydrite	808	
Shale & Shells	1326	DST #1 3433 - 3470
Shale & Limestone	1720	DST #2 3495 - 3560
Limestone & Shale	3055	
Limestone	3570	Ran electric log.
Dolomite	3660	
RTD	3660	Plugged hole @ 9:30 a.m. 9-3-66

D & A

FORMATION TOPS

Heebner	3177 (-1268)
Toronto	3195 (-1286)
Douglas	3215 (-1306)
Brown Limestone	3290 (-1381)
Lansing	3300 (-1391)
Conglomerate	3557 (-1648)
Arbuckle	3593 (-1684)
RTD	3660 (-1751)

RECEIVED
 SEP 12 1966
 CONSERVATION DIVISION
 Topeka, Kansas

STATE OF KANSAS)
) SS:
 COUNTY OF BARTON)

The undersigned, being duly sworn on oath, states that the above statement and log are true and a correct record and log of the well drilled at the location above described.

William S. Schachle
 William S. Schachle

Subscribed and sworn to before me this 9th day of September, 1966.

Delores Strecker
 Delores Strecker, Notary Public

My commission expires: August 27, 1969