


STATE OF KANSAS
STATE CORPORATION COMMISSION

Give All Information Completely
Make Required Affidavit
Mail or Deliver Report to:
Conservation Division
State Corporation Commission
211 No. Broadway
Wichita, Kansas

WELL PLUGGING RECORD

NORTH

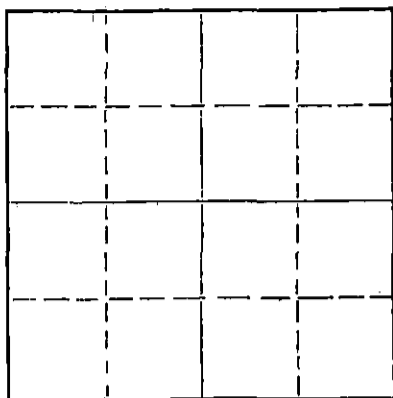

Locate well correctly on above
Section Plat

Ness County. Sec. 23 Twp. 20S Rge. 24W (X) (W)
Location as "NE/CNW/SW" or footage from lines C SE NW
Lease Owner Leben Drilling, Inc.
Lease Name Petersilie Well No. B-#1
Office Address Box 486, Great Bend, Kansas 67530
Character of Well (completed as Oil, Gas or Dry Hole) Dry Hole
Date well completed 3-12-67 19
Application for plugging filed 3-12-67 19
Application for plugging approved 3-12-67 19
Plugging commenced 3-12-67 19
Plugging completed 3-12-67 19
Reason for abandonment of well or producing formation Dry Hole

If a producing well is abandoned, date of last production _____ 19____
Was permission obtained from the Conservation Division or its agents before plugging was commenced? yes

Name of Conservation Agent who supervised plugging of this well Leo Massey
Producing formation _____ Depth to top _____ Bottom _____ Total Depth of Well 4400 Feet
Show depth and thickness of all water, oil and gas formations.

OIL, GAS OR WATER RECORDS

CASING RECORD

FORMATION	CONTENT	FROM	TO	SIZE	PUT IN	PULLED OUT
				8 5/8"	274'	none

Describe in detail the manner in which the well was plugged, indicating where the mud fluid was placed and the method or methods used in introducing it into the hole. If cement or other plugs were used, state the character of same and depth placed, from _____ feet to _____ feet for each plug set.

Bottom Plug @ 540' with 25 sks. cement through drill pipe
Plug @ 260' with 20 sks. Cement through drill pipe
Top plug @ 40' with 8 sacks cement

RECEIVED
STATE CORPORATION COMMISSION

MAR 14 1967

CONSERVATION DIVISION
WICHITA, KANSAS

(If additional description is necessary, use BACK of this sheet)

Name of Plugging Contractor Leben Drilling, Inc.
Address Box 486, Great Bend, Kansas 67530

STATE OF KANSAS, COUNTY OF BARTON, ss.
Leslie Kite

(employee of owner) or (owner or operator) of the above-described well, being first duly sworn on oath, says: That I have knowledge of the facts, statements, and matters herein contained and the log of the above-described well as filed and that the same are true and correct. So help me God.

(Signature) Leslie Kite

Box 486, Great Bend, Kansas 67530
(Address)

SUBSCRIBED AND SWORN TO before me this 13th day of March, 1967

My commission expires April 1, 1967

Ulanda Nichols
Notary Public.

DRILLER'S LOG

COMPANY: Leben Drilling, Inc.
 CONTRACTOR: LEBEN DRILLING, INC.
 FARM: PETERSILIE B-#1
 LOCATION: C SE NW SEC. 23-20S-24W
 NESS COUNTY, KANSAS
 COMMENCED: 3-2-67
 COMPLETED: 3-12-67

0	85	Post Rock, Clay
85	275	Clay, Shale
275	975	Shale, Redbed
975	1200	Sand
1200	1502	Shale
1502	1507	Anhydrite
1507	2230	Shale, Shells
2230	2755	Lime
2755	2851	Lime, Shale
2851	3300	Lime
3300	3770	Lime, Shale
3770	4376	Lime
4376	4400	Lime, Chert
	<u>4400</u>	<u>RTD - D & A</u>

RECEIVED
 STATE CORPORATION COMMISSION
 MAR 14 1967
 CONSERVATION DIVISION
 Topeka, Kansas

8 5/8" new 20# surface casing set @ 274' cemented with 185 sacks of Common, 2% cc

I, Leslie Kite, do hereby certify that the above and foregoing is a true and correct copy of the log of the Petersilie B-#1, C SE NW, Section 23, Township 20 South, Range 24 West, Ness County, Kansas, as reflected by the records of Leben Drilling, Inc.

Leslie Kite
 Leslie Kite

STATE OF KANSAS)
)
 COUNTY OF BARTON) SS

Subscribed and sworn to and before me, a Notary Public, in and for Barton County, Kansas, this 13th day of March, 1967.

Ulanda Nichols
 Ulanda Nichols

My Commission Expires:
 April 1, 1967