


WELL PLUGGING RECORD

Give All Information Completely  
Make Required Affidavit  
Mail or Deliver Report to:  
Conservation Division  
State Corporation Commission  
800 Bittig Building  
Wichita, Kansas

NORTH

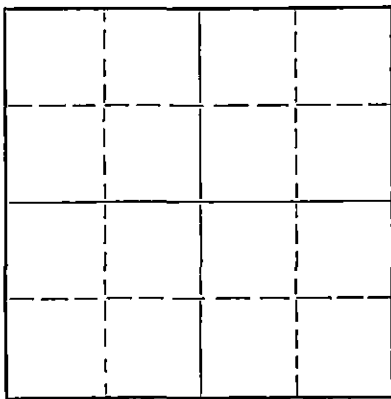

Locate well correctly on above  
Section Plat

Barton County. Sec. 32 Twp. 20 Rge. 14 (W)  
Location as "NE/CNW/SW" or footage from lines. SE SE NE  
Lease Owner North American Car Corporation  
Lease Name Esfeld "A" Well No. 1  
Office Address 506 Capherau Bldg., Wichita, Kansas  
Character of Well (completed as Oil, Gas or Dry Hole) Dry Hole  
Date well completed 12-1 1953  
Application for plugging filed 11-30 1953  
Application for plugging approved 11-30 1953  
Plugging commenced 2:00 P.M. 12-1 1953  
Plugging completed 4:00 P.M. 12-1 1953  
Reason for abandonment of well or producing formation \_\_\_\_\_

If a producing well is abandoned, date of last production \_\_\_\_\_ 19\_\_\_\_  
Was permission obtained from the Conservation Division or its agents before plugging was commenced? Yes Telephone to Mr. C. D. Stough

Name of Conservation Agent who supervised plugging of this well Mr. C. D. Stough  
Producing formation \_\_\_\_\_ Depth to top \_\_\_\_\_ Bottom \_\_\_\_\_ Total Depth of Well \_\_\_\_\_ Feet  
Show depth and thickness of all water, oil and gas formations.

OIL, GAS OR WATER RECORDS

CASING RECORD

FORMATION	CONTENT	FROM	TO	SIZE	PUT IN	PULLED OUT
				8 5/8"	863	none

Describe in detail the manner in which the well was plugged, indicating where the mud fluid was placed and the method or methods used in introducing it into the hole. If cement or other plugs were used, state the character of same and depth placed, from \_\_\_\_\_ feet to \_\_\_\_\_ feet for each plug set.

Hole filled with heavy rotary mud to 260'  
First Plug at 260' cemented through Drill Pipe with 20 sacks cement  
Hole filled with heavy rotary mud to 30'  
Second plug at 30' cemented through Drill Pipe with 10 sacks cement

STATE CORPORATION COMMISSION  
12-12-53  
WICHITA, KANSAS


(If additional description is necessary, use BACK of this sheet)  
Name of Plugging Contractor Honaker Drilling Company  
Address 2008 Lakin, Great Bend, Kansas

STATE OF Kansas, COUNTY OF Barton, ss.  
S. C. Lingreen (employee of owner) of the above-described well, being first duly sworn on oath, says: That I have knowledge of the facts, statements, and matters herein contained and the log of the above-described well as filed and that the same are true and correct. So help me God.

(Signature) S. C. Lingreen  
2008 Lakin, Great Bend, Kansas  
(Address)

SUBSCRIBED AND SWORN TO before me this 7th day of December, 1953

My commission expires 6-25-55 Notary Public.

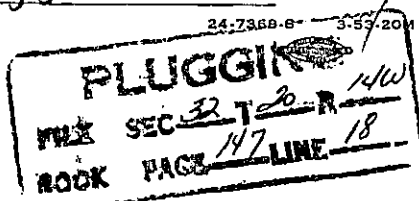

15.009.01392.0000

DRILLERS LOG

COMPANY: North American Gas Corporation

SEC: 32 T: 203 R: 147

FARM: Esfeld "A" # 1

LOCATION: SE SE NE  
Barton County, Kansas

WELL NO. 1

TOTAL DEPTH: 3645

COMH: 11-19-53 COMP: 12-1-53

CONTRACTOR: Honaker Drilling Company

ELEVATION: 1914 D F

CASING: 8 5/8" 863'

0	35	Sand	
35	150	Sand and Clay	
150	270	Clay and Shale	
270	360	Dakota Sand	
360	480	Red Bed	
480	625	Red Bed and Shale	
625	670	Blue Shale	
670	855	Red Bed	
855	895	Anhydrite	
895	1160	Red Bed, Shale and Shells	8 5/8" casing cemented @ 863'
1160	1340	Red Bed and Shale	with 450 sacks cement and 9
1340	1425	Salt and Shale	sacks calcium chloride
1425	1575	Shale and Shells	
1575	3150	Lime and Shale	
3150	3645	Lime	
3645		Total Rotary Depth	

I certify that this is the true and correct copy of the above log, to the best of my knowledge.

Joe J. Honaker

Subscribed and sworn to before me this 7 day of December 1953.

[Signature]  
Notary Public

My Commission Expires 6-25-55

PLUGGING  
FILE SEC 32 T 20 R 147  
BOOK PAGE 147 LINE 18

