

STATE OF KANSAS  
STATE CORPORATION COMMISSION  
CONSERVATION DIVISION  
P. O. BOX 17027  
WICHITA, KANSAS 67217

FORM CP-4

WELL PLUGGING RECORD

Kiowa County, Sec. 11 Twp. 30S Rge. (E) 18 (W)

Location as "NE/CNW/SE/SW" or footage from lines NW SE NW

Lease Owner R & E Drilling, Inc.

Lease Name Kane Unit Well No. 1-11

Office Address 816 Union Center Bldg., Wichita, Kansas 67202

Character of Well (completed as Oil, Gas or Dry Hole) Gas

Date well completed March 1967

Application for plugging filed August 1 1975

Application for plugging approved August 4 1975


Plugging commenced September 2 1975

Plugging completed September 4 1975

Reason for abandonment of well or producing formation depletion

If a producing well is abandoned, date of last production July 6 1975

Was permission obtained from the Conservation Division or its agents before plugging was commenced?

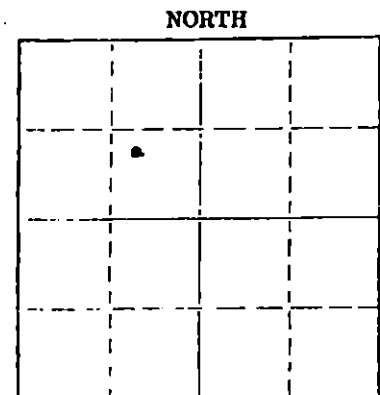

Locate well correctly on above Section Plat

Name of Conservation Agent who supervised plugging of this well Russell Biberstein

Producing formation Marmaton Depth to top 4763' Bottom 4773' Total Depth of Well 4925'

Show depth and thickness of all water, oil and gas formations.

OIL, GAS OR WATER RECORDS

CASING RECORD

FORMATION	CONTENT	FROM	TO	SIZE	PUT IN	PULLED OUT
				8 5/8"	460'	none
				5 1/2"	4910'	3059

Describe in detail the manner in which the well was plugged, indicating where the mud fluid was placed and the method or methods used in introducing it into the hole. If cement or other plugs were used, state the character of same and depth placed, from feet to feet for each plug set.

Pumped 2 sax hulls and 15 sax cement to 4620' with plug. Mud to 460'. Bridged with 35 sax cement from 460' to 360'. Bridge at 45' and filled 8 5/8" casing with cement (10 sax) to base of cellar.

Name of Plugging Contractor Sargent's Casing Pulling Service  
Address Box 506, Liberal, Kansas 67901

RECEIVED  
STATE CORPORATION COMMISSION

OCT 8 1975

STATE OF KANSAS COUNTY OF SEDGWICK ss. Wayne L. Brinegar

(employee of owner) or (owner or operator) of the above-described well, being first duly sworn on oath, says: That I have knowledge of the facts, statements, and matters herein contained and the log of the above-described well as filed and that the same are true and correct. So help me God.

(Signature) Wayne L. Brinegar 816 Union Center Bldg.

(Address) Wichita, Kansas 67202

SWORN to before me this 7th day of October 1975



October 29, 1978

Kay Woolsey Notary Public.

# DRILLER'S WELL LOG

OPERATOR: K & E DRILLING, INC.  
719 Union Center  
Wichita, Kansas 67202

WELL NAME: Kane Unit #1-11  
LOCATION: NW SE NW Sec. 11-30S-18W  
Kiowa County, Kansas

CONTRACTOR: K&E DRILLING, INC.  
719 UNION CENTER BLDG.  
WICHITA, KANSAS

COMMENCED: 3-1-67  
COMPLETED: 3-14-67  
ELEVATION: 2117' Grd., 2123' DF,  
2126' KB  
PRODUCTION: Gas

CASING RECORD:  
8-5/8" @ 460' w/300 sx.  
5-1/2" @ 4910' w/100 sx.  
ROTARY TOTAL DEPTH: 4925'

## FORMATION RECORD

Depths shown indicate bottom of formations encountered.

Sand & Shale	350
Red Bed	450
Anhydrite	480
Shale & Shells	2085
Lime	3145
Shale & Lime	3350
Lime	4867
Lime & Chert	4921
Lime	4925

RECEIVED  
STATE CORPORATION COMMISSION

AUG 4 1975

CONSERVATION DIVISION  
Wichita, Kansas

## CERTIFICATION

State of KANSAS }  
County of SEDGWICK } ss:

I, H. L. Wilson, of K&E DRILLING, INC., upon oath state that the above and foregoing is a true and correct copy of the Driller's Log of the above named well.

H. L. Wilson  
H. L. Wilson

Subscribed and sworn to before me this 21st day of March, 1967.

Judie K. Eby  
Judie K. Eby Notary Public.

Commission Expires: 9-14-70

