


STATE OF KANSAS  
STATE CORPORATION COMMISSION

Form CP-4

WELL PLUGGING RECORD

Give All Information Completely  
Make Required Affidavit  
Mail or Deliver Report to:  
Conservation Division  
State Corporation Commission  
212 N. Market  
Wichita, Kansas

NORTH

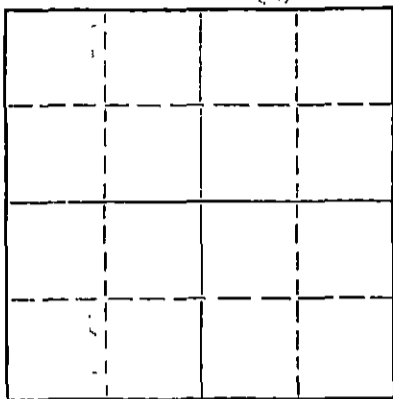

Locate well correctly on above  
Section Plat

Kiowa County, Sec. 14 Twp. 30 Rge. 14 (E) (W) x

Location as "NE/CNW/SW" or footage from lines C of NE SE

Lease Owner Graham-Michaelis Drilling Inc.

Lease Name Kane Well No. 1-14

Office Address 211 N. Broadway Wichita, Kansas

Character of Well (completed as Oil, Gas or Dry Hole)

Date well completed 19

Application for plugging filed 19

Application for plugging approved 19

Plugging commenced 12-11-67 19

Plugging completed 12-14-67 19

Reason for abandonment of well or producing formation

If a producing well is abandoned, date of last production 19

Was permission obtained from the Conservation Division or its agents before plugging was commenced?

Name of Conservation Agent who supervised plugging of this well Archie Elving

Producing formation Depth to top Bottom Total Depth of Well 5083' Feet

Show depth and thickness of all water, oil and gas formations.

OIL, GAS OR WATER RECORDS

CASING RECORD

FORMATION	CONTENT	FROM	TO	SIZE	PUT IN	PULLED OUT
				5 1/2"	5011'	4234.28'
				8 5/8"	468'	

Describe in detail the manner in which the well was plugged, indicating where the mud fluid was placed and the method or methods used in introducing it into the hole. If cement or other plugs were used, state the character of same and depth placed, from feet to feet for each plug set.

Made bottom hole plug back with sand to 5000'. Mixed and ran 5 sacks cement thru dump bailer.

Mudded hole to 325', set 25' rock bridge. Filled hole with 4 yards ready-mix from 300' to base of cellar.

DEC 18 1967

12-18-67  
CONSERVATION DIVISION  
WICHITA, KANSAS

Name of Plugging Contractor Southwest Casing Pulling Co., Inc.  
Address Box 364, Great Bend, Kansas

STATE OF Kansas, COUNTY OF Barton, ss.  
Southwest Casing Pulling Co., Inc. (employee of owner) or (owner or operator) of the above-described well, being first duly sworn on oath, says: That I have knowledge of the facts, statements, and matters herein contained and the log of the above-described well as filed and that the same are true and correct. So help me God.

(Signature) W. C. Spencer Sec.  
Box 364, Great Bend, Kansas (Address)

SUBSCRIBED AND SWORN TO before me this 15 day of December, 19 67

My commission expires October 1968



Sidney D. Miller Notary Public.

KANE NO. 1-14

## WELL RECORD:

## LOCATION:

C NE/4 SE/4 Section 14-30S-18W  
 Kiowa County, Kansas

Commenced: 8-19-67  
 Completed: 9-2-67  
 (Rotary)

## CONTRACTOR:

Graham-Michaelis Drilling, Inc.  
 Liberal Division  
 P. O. Box 1294  
 Liberal, Kansas 67901

## CASING RECORD:

15 Joints 8-5/8" 24# Casing Set  
 at 467' - Cemented w/300 sx Sunset

LOG

Surface Sand & Red Bed  
 Gyp & Sand  
 Red Bed & Gyp  
 Anhy, Gyp & Red Bed  
 Lime & Shale  
 Red Bed, Gyp & Shale  
 Lime & Shale  
 Lime  
 Lime & Shale  
 Lime  
 Lime & Shale  
 Lime  
 Lime & Shale

0 - 404  
 404 - 472  
 472 - 864  
 864 - 1364  
 1364 - 1795  
 1795 - 1845  
 1845 - 4445  
 4445 - 4568  
 4568 - 4728  
 4728 - 4789  
 4789 - 4853  
 4853 - 4865  
 4865 - 5020

5020' - Total Rotary Depth

The undersigned, Graham-Michaelis Drilling, Inc., Liberal Division, certifies that the above log is a true and correct copy of the formations encountered in drilling the above mentioned well, as taken from the Daily Drilling Report.

GRAHAM-MICHAELIS DRILLING, INC.  
 LIBERAL DIVISION

By 

H. R. Michaelis

HRM/rw

RECEIVED  
 SEP 26 1967  
 CONSERVATION DIVISION  
 Wichita, Kansas