


STATE OF KANSAS  
STATE CORPORATION COMMISSION

Form CP-4

Give All Information Completely  
Make Required Affidavit  
Mail or Deliver Report to:  
Conservation Division  
State Corporation Commission  
212 No. Market  
Wichita, Kansas

WELL PLUGGING RECORD

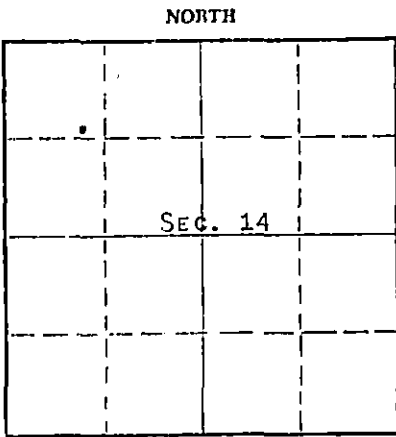

Locate well correctly on above Section Plat

Location as "NE/CNW/SW" or footage from lines KIOWA County, Sec. 14 Twp. 30S Rge. 18W (X) (W)  
APP. C NW NW  
Lease Owner PETROLEUM, INC.  
Lease Name KANE Well No. G-1  
Office Address R.R. #2, GREAT BEND, KANSAS  
Character of Well (completed as Oil, Gas or Dry Hole) DRY HOLE  
Date well completed MARCH 31 1968  
Application for plugging filed MARCH 31 1968  
Application for plugging approved MARCH 31 1968  
Plugging commenced MARCH 31 1968  
Plugging completed MARCH 31 1968  
Reason for abandonment of well or producing formation NO PRODUCIBLE ZONE

If a producing well is abandoned, date of last production NONE 19      
Was permission obtained from the Conservation Division or its agents before plugging was commenced? YES

Name of Conservation Agent who supervised plugging of this well HERMAN JUSTUS  
Producing formation      Depth to top      Bottom      Total Depth of Well 5040 Feet  
Show depth and thickness of all water, oil and gas formations.

OIL, GAS OR WATER RECORDS

CASING RECORD

FORMATION	CONTENT	FROM	TO	SIZE	PUT IN	PULLED OUT
				8-5/8"	525'	NONE

Describe in detail the manner in which the well was plugged, indicating where the mud fluid was placed and the method or methods used in introducing it into the hole. If cement or other plugs were used, state the character of same and depth placed, from      feet to      feet for each plug set.

MUD TO 480', FOLLOWED BY WOODEN PLUG, PLACED 1/2 SACK HULLS AND 25 SACKS CEMENT ON TOP OF PLUG. MUD TO 40', FOLLOWED BY WOODEN PLUG, PLACED 1/2 SACK HULLS AND 10 SACKS CEMENT ON TOP OF PLUG TO BASE OF WELL CELLAR.

RECEIVED  
STATE CORPORATION COMMISSION  
APR 12 1968  
CONSERVATION DIVISION  
Wichita, Kansas

(If additional description is necessary, use BACK of this sheet)

Name of Plugging Contractor GARVEY DRILLING COMPANY  
Address R.R. #2, GREAT BEND, KANSAS

STATE OF KANSAS, COUNTY OF BARTON, ss.  
MONTE CHADD (employee of owner) or (~~owner~~) of the above-described well, being first duly sworn on oath, says: That I have knowledge of the facts, statements, and matters herein contained and the log of the above-described well as filed and that the same are true and correct. So help me God. MONTE CHADD, DIST. PROD. Supt.

(Signature) *Monte Chadd*  
R.R. #2, GREAT BEND, KANSAS  
(Address)

SUBSCRIBED AND SWORN TO before me this 11 day of APRIL, 19 68

*Richard H. Dumber*  
Notary Public.

# WELL LOG

COMPANY Petroleum, Inc.

SEC. 14 T. 30S R. 18W

FARM Kane

NO. G-1

LOC. App C-NW-NW


TOTAL DEPTH 5040'

COUNTY Kiowa

COMM. 3-18-68

COMP. 3-31-68

CONTRACTOR Garvey Drilling Company

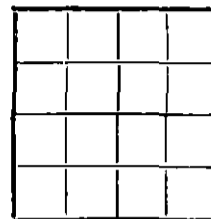

CASING 8 5/8" @ 525' w/350 sx

ELEVATION 2148' DF

PRODUCTION D & A

FIGURES INDICATE BOTTOM OF FORMATIONS

- 458' Red Bed
- 515' Anhydrite
- 1037' Red Bed and Shale
- 1229' Anhydrite and Shale
- 1990' Red Bed, Shale, Lime and Shells
- 2115' Shale
- 2550' Lime and Shale
- 2690' Lime
- 2756' Lime and Shale
- 2895' Shale and Lime
- 3311' Lime and Shale
- 3645' Shale
- 3778' Lime and Shale
- 3885' Lime
- 4350' Lime and Shale
- 4450' Lime
- 4486' Lime and Shale
- 4565' Lime
- 4660' Lime and Shale
- 4735' Lime
- 4995' Lime and Shale
- 5040' Cherty Lime
- 5040' RTD

RECEIVED  
STATE CORPORATION COMMISSION  
APR 12 1968  
CONSERVATION DIVISION  
Wichita, Kansas

State of Kansas }  
County of Barton } ss

I, Sam N. Stephens of Garvey Drilling Company

upon oath state the above and foregoing is a true and correct copy of the log of the Kane G-1 well.

*Sam N. Stephens*

Subscribed and sworn to before me this 9th day of April 19 68

My Commission Expires: November 5th, 1969

*Richard D. Doep*  
NOTARY PUBLIC