


Give All Information Completely
Make Required Affidavit
Mail or Deliver Report to
Conservation Division
State Corporation Commission
211 No. Broadway
Wichita, Kansas

WELL PLUGGING RECORD

Kiowa County, Sec. 16 Twp. 30S Rge. (E) 18 (W)

Location as "NE/CNW/SW" or footage from lines 1980' FSL & 1250' FWL
Lease Owner Anadarko Production Company
Lease Name Emerson "A" Well No. 1
Office Address P. O. Box 351 Liberal, Kansas
Character of Well (completed as Oil, Gas or Dry Hole) Dry Hole
Date well completed 10-22 1966
Application for plugging filed 10-22 1966
Application for plugging approved 10-22 1966
Plugging commenced 10-22 1966
Plugging completed 10-22 1966
Reason for abandonment of well or producing formation Dry Hole

NORTH

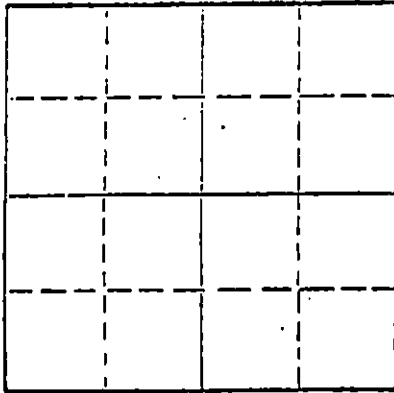

Locate well correctly on above
Section Plat

If a producing well is abandoned, date of last production - 19
Was permission obtained from the Conservation Division or its agents before plugging was commenced? Yes

Name of Conservation Agent who supervised plugging of this well Archie V. Elving, Pratt, Kansas
Producing formation - Depth to top - Bottom - Total Depth of Well 5188 Feet
Show depth and thickness of all water, oil and gas formations.

OIL, GAS OR WATER RECORDS

CASING RECORD

FORMATION	CONTENT	FROM	TO	SIZE	PUT IN	PULLED OUT
				8-5/8"	1030'	None

Describe in detail the manner in which the well was plugged, indicating where the mud fluid was placed and the method or methods used in introducing it into the hole. If cement or other plugs were used, state the character of same and depth placed, from _____ feet to _____ feet for each plug set.

Spotted 25 sacks of cement at 1000' formed bridge,
Filled hole with mud to 300' fromed bridge.
Spotted 25 sacks of cement at 300',
Filled hole with mud to 40' formed bridge.
Spotted 15 sacks of cement from 40' to 0'
Plugged rat hole & mouse hole w/10 sacks of cement.
Complete @ 6:30 p.m. 10-22-66.

11-1-66
STATE CORPORATION COMMISSION
NOV 7 1966
CONSERVATION DIVISION
Wichita, Kansas

(If additional description is necessary, use BACK of this sheet)
Name of Plugging Contractor Bowers Drilling Company, Inc.
Address 1434 Wichita Plaza Building, Wichita, Kansas 67202

STATE OF Kansas, COUNTY OF Seward, ss.
V. K. Downey (employee of owner) or (owner or operator) of the above-described well, being first duly sworn on oath, says: That I have knowledge of the facts, statements, and matters herein contained and the log of the above-described well as filed and that the same are true and correct. So help me God.

V. K. Downey, Supt. Liberal Production Region (Signature)
P. O. Box 351 Liberal, Kansas (Address)

SUBSCRIBED AND SWORN to before me this 31st day of October, 1966.
Donald L. Vangieson Notary Public.

DRILLER'S LOG

WELL NAME: Emerson "A" No. 1; COMPANY OPERATING: Anadarko Production Company
 ADDRESS of COMPANY: Box 351 Liberal, Kansas

WELL LOCATION: 1/4 1/4 SW 1/4,
1980 ft. North of South line,
1250 ft. East of West line; Sec. 16, Twp. 30S, Rge. 18W, Kiowa County, Kansas

DRILLING STARTED 10-6, 1966; DRILLING COMPLETED 10-22, 1966
 WELL COMPLETED 10-22, 1966; WELL CONNECTED _____, 19____

ELEVATION: 2219 ft. Ground Level; CHARACTER OF WELL (Oil, Gas, or Dry Hole) Dry Hole

OIL OR GAS SANDS OR ZONES - PERFORATIONS - ACIDIZING AND FRACTURING INFORMATION					
Name	From	To	No. of Shots	Gallons Used	Kind Used

CASING RECORD

Size	Amount Set	Sacks of Cement	Amount Pulled
8-5/8"	1030'	650	None

FORMATION RECORD

Formation	Top	Bottom	Formation	Top	Bottom
Surface Sand	0	640			
Red Bed	640	1200			
Red Bed, Shale & Shells	1200	1810			
Shale & Shells	1810	2514			
Lime & Shale	2514	4515			
Lime	4515	4585			
Lime & Shale	4585	4621			
Lime	4621	5188			
TOTAL DEPTH		5188			

RESULTS of INITIAL PRODUCTION TEST: Plugged and Abandoned on 10/22/66.