


STATE OF KANSAS  
STATE CORPORATION COMMISSION

WELL PLUGGING RECORD

Give All Information Completely  
Make Required Affidavit  
Mail or Deliver Report to  
Conservation Division  
State Corporation Comm.  
245 North Water  
Wichita, KS 67202

Kiowa County, Sec. 16 Twp. 30 S Rge. 18  $\frac{1}{2}$ W  
Location as "NE/CNW $\frac{1}{2}$ SW $\frac{1}{2}$ " or footage from lines  
C W/2 NW

Lease Owner Maurice L. Brown Co.  
Lease Name Schmidt Well No. 1  
Office Address 200 Sutton Place Bldg., Wichita, Ks. 67202  
Character of Well (Completed as Oil, Gas or Dry Hole)  
Dry Hole

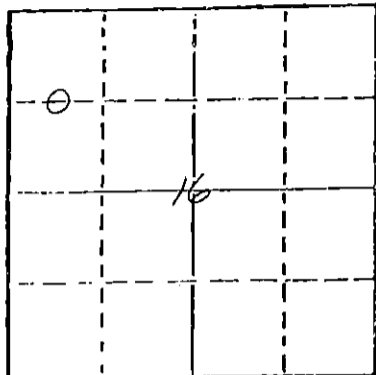

Locate well correctly on above  
Section Plot

Date Well completed May 25 1978  
Application for plugging filed (verbally) May 25 1978  
Application for plugging approved (verbally) May 25 1978  
Plugging commenced May 25 1978  
Plugging completed May 25 1978  
Reason for abandonment of well or producing formation  
No commercial quantity of oil or gas encountered  
If a producing well is abandoned, date of last production 19

Was permission obtained from the Conservation Division or  
its agents before plugging was commenced? Yes

Name of Conservation Agent who supervised plugging of this well Bill Owens  
Producing formation \_\_\_\_\_ Depth to top \_\_\_\_\_ Bottom \_\_\_\_\_ Total Depth of Well 5175  
Show depth and thickness of all water, oil and gas formations.

OIL, GAS OR WATER RECORDS

CASING RECORD

FORMATION	CONTENT	FROM	TO	SIZE	PUT IN	PULLED OUT

Describe in detail the manner in which the well was plugged, indicating where the mud fluid  
was placed and the method or methods used in introducing it into the hold. If cement or other  
plugs were used, state the character of same and depth placed, from \_\_\_\_\_ feet to  
\_\_\_\_\_ feet for each plug set.

Set 1st plug at 570' with 50 sacks  
2nd plug at 40' with 12 sacks  
3rd plug in rathole with 3 sacks  
Plug was down at 7:15 a.m., May 25, 1978  
Cemented with common cement.

RECEIVED  
STATE CORPORATION COMMISSION  
MAY 31 1978  
5-31-78  
CONSERVATION DIVISION  
Wichita, Kansas

(If additional description is necessary, use BACK of this sheet)


Name of Plugging Contractor Abercrombie Drilling, Inc.

STATE OF KANSAS COUNTY OF SEDGWICK, ss.

Jack L. Partridge, Ass't. Sec.-Treas. (employee of owner) or (owner or operator)  
of the above-described well, being first duly sworn on oath, says: That I have knowledge of  
the facts, statements, and matters herein contained and the log of the above-described well  
as filed and that the same are true and correct. So help me God.

(Signature) Jack L. Partridge  
801 Union Center, Wichita, Kansas 67202  
(Address)

SUBSCRIBED AND SWORN TO before me this 30th day of May, 19 78

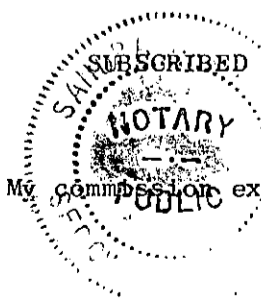

Sandra Richman  
Sandra Richman Notary Public.

My commission expires July 21, 1979

OPERATOR: The Maurice L. Brown Co.  
 CONTRACTOR: Abercrombie Drilling, Inc.  
 WELL NAME: Schmidt #1  
 LOCATION: C W/2 NW Section 16-30S-18W  
 Kiowa County, Kansas  
 SPUD DATE: May 9, 1978  
 COMPLETION DATE: May 25, 1978

0	192	Top soil & sand
192	482	Sand & red bed
482	504	Anhydrite
504	1000	Red beds & shells
1000	1140	Shale
1140	2892	Shale & lime
2892	4352	Lime & shale
4352	4410	Shale & lime
4410	4647	Lime & shale
4647	4726	Shale & lime
4726	4798	Lime, shale & chert
4798	4890	Lime & shale
4890	5014	Shale & lime
5014	5060	Lime, shale & chert
5060	5080	Lime
5080	5104	Shale & lime
5104	5175	Lime
	5175	Rotary Total Depth

Spud hole at 9:00 p.m., May 9, 1978. Drilled 1,000' of 12 1/4" hole. Ran 16 joints of 24# - 8-5/8" surface casing. Set at 562' K.B. Used guide shoe, insert float and 3 centralizers. Strapped bottom 3 collars. Ran 15 bbls. of fresh water followed by 300 sacks of Halliburton Light, 3% CaCl, and 1/2 sack Flo-seal. Followed with 150 sacks Class "A" cement, 3% CaCl, and 1/2 sack Flo-seal. Plug was down at 2:00 p.m., May 10, 1978. Cement did circulate.

T.D. 5175'. Set first plug at 570' with 50 sacks, second plug at 40' with 12 sacks and third plug with 3 sacks in rathole. Cemented with common cement. Plug was down at 7:15 a.m., May 25, 1978.

RECEIVED  
 COMMISSIONER

STATE OF KANSAS )  
 ) ss  
 COUNTY OF SEDGWICK )

MAY 31 1978  
 DIVISION  
 Kansas


Jack L. Partridge, Assistant Secretary-Treasurer of Abercrombie Drilling, Inc., does hereby state that the above and foregoing is a true and correct copy of the log of the Schmidt #1, C W/2 NW Section 16-30S-18W, Kiowa County, Kansas.

ABERCROMBIE DRILLING, INC.

BY Jack L. Partridge  
 Jack L. Partridge,  
 Assistant Secretary-Treasurer

Subscribed and sworn to before me, a Notary Public, in and for the county and state aforesaid, as of this 30th day of May, 1978.

Sandra Richman  
 Sandra Richman, Notary Public

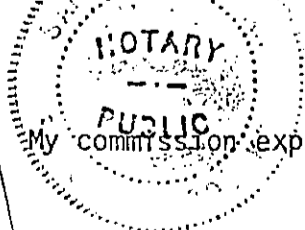

My commission expires July 21, 1979.