

STATE OF KANSAS
STATE CORPORATION COMMISSION

WELL PLUGGING RECORD

Give All Information Completely
Make Required Affidavit
Mail or Deliver Report to
Conservation Division
State Corporation Comm.
245 North Water
Wichita, KS 67202

Kiowa County, Sec. 22 Twp. 30 Rge. 18 E/W
Location as "NE/CNW 1/4 SW 1/4" or footage from lines
C NW SW

Lease Owner Aylward Drilling Company
Lease Name Paxton Unit Well No. 2
Office Address 909 First National Bank Bldg. Wichita, Ks.
Character of Well (Completed as Oil, Gas or Dry Hole) Dry Hole


Date Well completed May 18, 1978
Application for plugging filed May 18, 1978
Application for plugging approved May 18, 1978
Plugging commenced May 18, 1978
Plugging completed May 18, 1978

Reason for abandonment of well or producing formation Dry Hole

If a producing well is abandoned, date of last production 19

Was permission obtained from the Conservation Division or its agents before plugging was commenced? yes

Name of Conservation Agent who supervised plugging of this well Bill Owen - Pratt, Kansas
Producing formation _____ Depth to top _____ Bottom _____ Total Depth of Well 5100'
Show depth and thickness of all water, oil and gas formations.

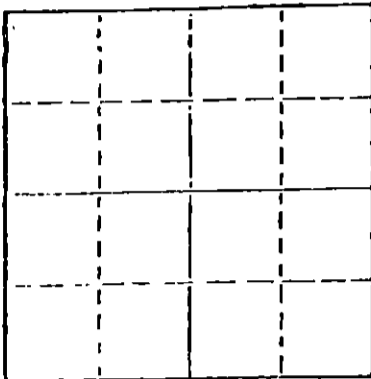

Locate well correctly on above Section Plat

OIL, GAS OR WATER RECORDS

CASING RECORD

FORMATION	CONTENT	FROM	TO	SIZE	PUT IN	PULLED OUT
	Surface					
	Casing	0	560	8 5/8	560'	none

Describe in detail the manner in which the well was plugged, indicating where the mud fluid was placed and the method or methods used in introducing it into the hold. If cement or other plugs were used, state the character of same and depth placed, from _____ feet to _____ feet for each plug set.

Plugged at 240 feet with 50 sacks cement,
40 feet with 12 sacks cement, 3 sacks
in rat hole. Job completed at 11:00 A.M.
May 18, 1978

RECEIVED
STATE CORPORATION COMMISSION
MAY 22 1978
CONSERVATION DIVISION
Wichita, Kansas

5-28-78

(If additional description is necessary, use BACK of this sheet)

Name of Plugging Contractor Sun Cementing Company

STATE OF Kansas COUNTY OF Sedgwick, ss.
W. J. Froelich, Jr. (employee of owner) or (owner or operator)
of the above-described well, being first duly sworn on oath, says: That I have knowledge of the facts, statements, and matters herein contained and the log of the above-described well as filed and that the same are true and correct. So help me God.

(Signature)

W. J. Froelich Jr.
Wichita, Kansas

(Address)

SUBSCRIBED AND SWORN TO before me this 18th day of May, 1978

Maxine Dressen
Maxine Dressen Notary Public.

My commission expires February 22, 1981



DRILLERS LOGPAXTON UNIT #2

CASING RECORD:
8 5/8" set at 560'
with 450 sacks cement

OPERATOR: Aylward Drilling Company

DESCRIPTION:

TOTAL DEPTH:

CONTRACTOR: Search Drilling Company

C NW SW
Section 22-30S-18W
Kiowa County,
Kansas

5100'

COMMENCED: May 9, 1978

COMPLETED: May 18, 1978

<u>FORMATION</u>	<u>FROM</u>	<u>TO</u>	<u>REMARKS</u>
Sand	0	90	
Red Bed	290	457	
Red Bed and Shale	457	1200	
Shale	1200	1450	
Lime and Shale	1450	1612	
Lime and Shale	1612	2601	
Lime and Shale	2601	3203	
Lime and Shale	3203	3910	
Lime and Shale	3910	4507	
Lime and Shale	4507	4855	
Lime and Shale	4855	5060	
Lime and Shale	5060	5100	
Rotary Total Depth	5100		Dry and Abandoned

RECEIVED
STATE CORPORATION COMMISSION

MAY 22 1978

CONSERVATION DIVISION
Wichita, Kansas

I certify that this is a true and correct copy of the above log to the best of my knowledge

SEARCH DRILLING COMPANY

W. J. Froelich, Jr.
W. J. Froelich, Jr.

Subscribed and sworn to before me this 18th day of May, 1978.

My appointment expires:
February 22, 1981

Maxine Dressen
Maxine Dressen Notary Public

