


WELL PLUGGING RECORD

Give All Information Completely  
Make Required Affidavit  
Mail or Deliver Report to:  
Conservation Division  
State Corporation Commission  
800 Bitting Building  
Wichita, Kansas

Location as "NE/CNW $\frac{1}{4}$ SW $\frac{1}{4}$ " or footage from lines Barton County. Sec. 34 Twp. 20S Rge. 12 (W)  
Lease Owner Grant Oil Company  
Lease Name Foelgner Well No. 2  
Office Address 518 W K H Building, Wichita 2, Kansas  
Character of Well (completed as Oil, Gas or Dry Hole) oil  
Date well completed Sept. 15 1949  
Application for plugging filed Feb. 14 1958  
Application for plugging approved Feb. 17 1958  
Plugging commenced Feb. 19 1958  
Plugging completed Feb. 25 1958  
Reason for abandonment of well or producing formation Dry  
If a producing well is abandoned, date of last production January 1958  
Was permission obtained from the Conservation Division or its agents before plugging was commenced? YES

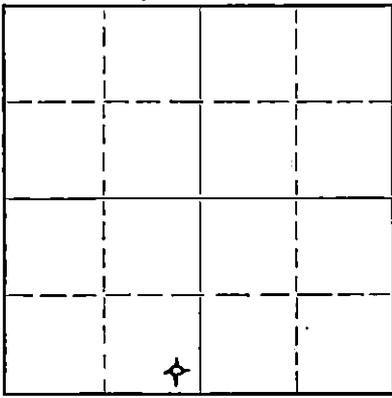

Locate well correctly on above Section Plat

Name of Conservation Agent who supervised plugging of this well Donald Truan  
Producing formation Arbuckle Depth to top 3407 Bottom 3420 Total Depth of Well 3420 Feet  
Show depth and thickness of all water, oil and gas formations.

OIL, GAS OR WATER RECORDS

CASING RECORD

Formation	Content	From	To	Size	Put In	Pulled Out
Surface	water	0	254	8 5/8	254	0
Arbuckle	oil	3407	3420	5 1/2	3402	2814

Describe in detail the manner in which the well was plugged, indicating where the mud fluid was placed and the method or methods used in introducing it into the hole. If cement or other plugs were used, state the character of same and depth placed, from \_\_\_\_\_ feet to \_\_\_\_\_ feet for each plug set.

Sand from 3344 to 3280. Dump 5 sacks of cement with dump bailer, mud up to 260', 10' rock bridge, dump 8 sacks of cement with baler, left set over night, bailed fluid off, left set 30 min., dump 17 sacks mud up to 40', 10' rock bridge, 10 sacks cement up to base of cellar.

RECEIVED

STATE CORPORATION COMMISSION

MAR 15 1958

3-15-58

CONSERVATION DIVISION

Wichita, Kansas

(If additional description is necessary, use BACK of this sheet)

Name of Plugging Contractor Arnett Casing Pulling Company  
Address 172 W. Third, Hoisington, Kansas

STATE OF Kansas, COUNTY OF Sedgwick, ss.  
I, W. A. Grant (owner or operator) of the above-described well,

being first duly sworn on oath, says: That I have knowledge of the facts, statements, and matters herein contained and the log of the above-described well as filed and that the same are true and correct. So help me Gdd.

(Signature) W. A. Grant  
518 W K H Building, Wichita 2, Kansas  
(Address)

SUBSCRIBED AND SWORN to before me this 14th day of March, 1958.

My commission expires April 29, 1961

Norma Richey  
Notary Public.

PLUGGING  
FILE SEC. 34 T. 20. R. 12W  
BOOK PAGE 82 LINE 29

15.009.07515.0000

FOELAGER NO. 2

Sec. 34-202-12W, Barton County, Kansas

Rigging up Rotary Tools 8-31-49  
 Tearing down Rotary Tools 9-9-49  
 Rigging up Cable Tools 9-10-49  
 Tearing down Cable Tools 9-19-49

Run 7 Jts 8 5/8" casing. Set at 296'  
 and cemented with 200 sacks cement.  
 Run 83 Jts. 5 1/2" casing. Set at 3402'  
 and cemented with 100 sacks cement.

FORMATION	FEET	TO
Sand	0	220
Sand and clay	220	274
Red bed and shale	274	610
Anhydrite	610	660
Shale and salt	660	980
Shale and shales	980	1260
Shale and lime	1260	1613
Lime	1613	1935
Shale and lime	1935	3028
Lime	3028	3169
Shale and lime	3169	3244
Lime	3244	3390
Shale and lime	3390	3407
Lime	3407	3400 Total Depth

I, Ben S. Facher, hereby certify that the above log is true and correct, to the best of my knowledge and belief.

Subscribed and sworn to before me this 17th day of October, 1949.

Notary Public

My commission expires: March 22, 1952

27 20 12W  
 82 29