


STATE OF KANSAS
STATE CORPORATION COMMISSION

R
WELL PLUGGING RECORD

Give All Information Completely
Make Required Affidavit
Mail or Deliver Report to:
Conservation Division
State Corporation Commission
211 N. Broadway
Wichita, Kansas

Barton County. Sec. 34 Twp. 20S Rge. 12W (E) (W)
Location as "NE/CNW/SW" or footage from lines 100' FSL & 1650' FWL of SE/4
Lease Owner Kewanee Oil Company
Lease Name Lanter Well No. 15
Office Address Box 360, Hoisington, Kansas
Character of Well (completed as Oil, Gas or Dry Hole) Oil
Date well completed March 2, 1956
Application for plugging filed October 9, 1959
Application for plugging approved October 12, 1959
Plugging commenced October 27, 1959
Plugging completed November 2, 1959
Reason for abandonment of well or producing formation Dry

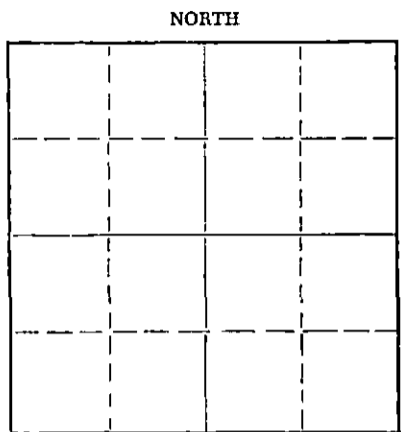

Locate well correctly on above
Section Plat

If a producing well is abandoned, date of last production March 20, 1959
Was permission obtained from the Conservation Division or its agents before plugging was commenced? Yes

Name of Conservation Agent who supervised plugging of this well Mr. Donald Truan, Russell, Kansas
Producing formation Arbuckle Depth to top 3398 Bottom 3425 Total Depth of Well 3425 Feet
Show depth and thickness of all water, oil and gas formations.

OIL, GAS OR WATER RECORDS

CASING RECORD

FORMATION	CONTENT	FROM	TO	SIZE	PUT IN	PULLED OUT
Heebner	Dry	3020		8-5/8"	245	None
Brown Lime	Dry	3152		5-1/2"	3401	2748
Lansing	Dry	3167				
Arbuckle	Oil	3398	3425			

Describe in detail the manner in which the well was plugged, indicating where the mud fluid was placed and the method or methods used in introducing it into the hole. If cement or other plugs were used, state the character of same and depth placed, from _____ feet to _____ feet for each plug set.

Measured into Total Depth at 3425'.
Sanded back to 3390' and dumped 5 sacks of cement.
Shot and pulled 5-1/2" Casing.
Pushed plug to 240'. Set rock bridge and dumped 2 sacks of cement and 1 sack of Calseal.
Bailed hole down and dumped 25 sacks of cement.
Filled hole with mud to 40'. Set rock bridge and capped well with 10 sacks of cement.

RECEIVED
STATE CORPORATION COMMISSION
NOV 16 1959
CONSERVATION DIVISION
Wichita, Kansas

(If additional description is necessary, use BACK of this sheet)
Name of Plugging Contractor Forbes Casing Pulling Company
Address Box 221, Great Bend, Kansas

STATE OF Kansas, COUNTY OF Barton, ss.
Peter Blanda (employee of owner) or (owner or operator) of the above-described well, being first duly sworn on oath, says: That I have knowledge of the facts, statements, and matters herein contained and the log of the above-described well as filed and that the same are true and correct. So help me God.
(Signature) Peter Blanda
Box 360, Hoisington, Kansas (Address)

SUBSCRIBED AND SWORN to before me this 10th day of November, 19 59
My commission expires September 21, 1961
[Signature] Notary Public.



KEWANEE OIL COMPANY

WELL RECORD: Lanter #15

Elevation: 1846' Cement Marker

Location: 100' from south line and 1650' from west line of SE/4 Section 34,
T-20-S, R-12-W, Barton County, Kansas.

Drilling Commenced: February 8, 1956.

Completed: March 2, 1956.

Total Depth: 3425' C.M.

Treating Record: Acidized Arbuckle 3406' to 3425' w/1000 gal type "J" 15%
on 2-28-56. Sand-oil treated 3401 to 3425' w/ 2000 gal.

Initial Production: Pumped 67.23 BO and 10.06 BW in 24 hours.

Halliburton Tops

Heebner Shale	3020 (-1174)
Brown Lime	3152 (-1306)
Lansing-Kansas City Lime	3167 (-1321)
"Weathered" Arbuckle	3398 (-1552)
"True" Arbuckle	3406 (-1560)

Casing Record

8-5/8" casing set at 244.70' C.M. w/ 250 sx 2% gel.
5-1/2" casing set at 3401.20' C.M. w/ 100 sacks.

Formation Record

0	Surface
90	Clay & sand
230	Sand
250	Red bed
623	Red rock & shale
640	Anhydrite
1400	Shale
2105	Shale & lime
2160	Lime
2355	Shale & lime
2540	Shale & lime streaks
2655	Shale & lime
2985	Lime
3080	Lime & shale
3230	Lime
3308	Lime & shale
3355	Lime
3400	Lime & shale
3425	Arbuckle - Total Depth