


STATE OF KANSAS  
STATE CORPORATION COMMISSION

WELL PLUGGING RECORD

Give All Information Completely  
Make Required Affidavit  
Mail or Deliver Report to  
Conservation Division  
State Corporation Comm.  
245 North Water  
Wichita, KS 67202

Barton County. Sec. 33 Twp. 20 Rge. 12 N/W  
Location as "NE/CNW/SW" or footage from lines NE SE SE

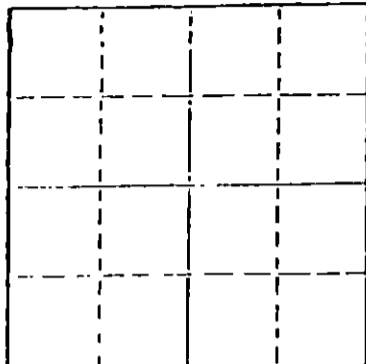

Lease Owner August Krueger - L. D. Davis  
Lease Name Krueger Well No. 1  
Office Address Route #1, Box 183B, Great Bend, KS 67530  
Character of Well (Completed as Oil, Gas or Dry Hole) Dry Hole  
Date Well completed November 2, 19 82  
Application for plugging filed November 2, 19 82  
Application for plugging approved November 2, 19 82  
Plugging commenced 2:15 AM November 2, 19 82  
Plugging completed 3:15 AM November 2, 19 82  
Reason for abandonment of well or producing formation \_\_\_\_\_

If a producing well is abandoned, date of last production 19  
Was permission obtained from the Conservation Division or its agents before plugging was commenced? Yes

Name of Conservation Agent who supervised plugging of this well Marion Schmidt  
Producing formation \_\_\_\_\_ Depth to top \_\_\_\_\_ Bottom \_\_\_\_\_ Total Depth of Well 3475'  
Show depth and thickness of all water, oil and gas formations.

OIL, GAS OR WATER RECORDS

CASING RECORD

FORMATION	CONTENT	FROM	TO	SIZE	PUT IN	PULLED OUT

Describe in detail the manner in which the well was plugged, indicating where the mud fluid was placed and the method or methods used in introducing it into the hold. If cement or other plugs were used, state the character of same and depth placed, from \_\_\_\_\_ feet to \_\_\_\_\_ feet for each plug set.

Spotted 20 SX. AT 3450'  
80 SX. AT 660'  
40 SX. AT 290'  
10 SX. AT 40'  
10 SX. in Rat Hole


RECEIVED  
STATE CORPORATION COMMISSION  
NOV-05-1982  
CONSERVATION DIVISION  
Wichita, Kansas

(If additional description is necessary, use BACK of this sheet)

Name of Plugging Contractor L. D. Drilling, Inc.

STATE OF Kansas COUNTY OF Barton, ss.  
Don Popp (employee of owner) or (owner or operator)

of the above-described well, being first duly sworn on oath, says: That I have knowledge of the facts, statements, and matters herein contained and the log of the above-described well as filed and that the same are true and correct. So help me God.

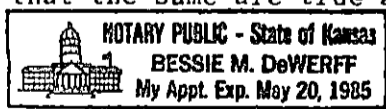

(Signature) Don Popp  
Don Popp Hoisington, Kansas  
(Address)

SUBSCRIBED AND SWORN TO before me this 3rd day of November, 19 82

My commission expires 5-20-85  
Bessie M. DeWerff Notary Public.