

STATE OF KANSAS
STATE CORPORATION COMMISSION


Give All Information Completely
Make Required Affidavit
Mail or Deliver Report to:
Conservation Division
State Corporation Commission
800 Bittling Building
Wichita, Kansas

15.009.14565.0001
WELL PLUGGING RECORD

OR
FORMATION PLUGGING RECORD

Strike out upper line
when reporting plug-
ging off formations.

NORTH

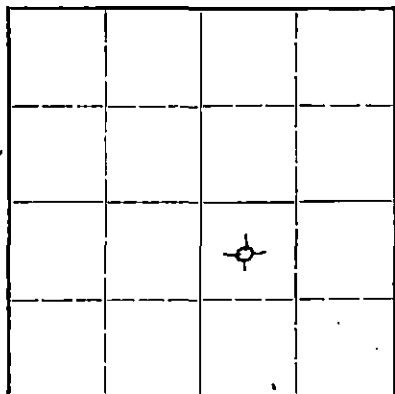

Locate well correctly on above
Section Plat

Barton County. Sec. 16 Twp. 20 Rge 11 (E) W (W)
Location as "NE $\frac{1}{4}$ NW $\frac{1}{4}$ SW $\frac{1}{4}$ " or footage from lines C NW $\frac{1}{4}$ SE $\frac{1}{4}$
Lease Owner. Holl & Henderson
Lease Name. Scheufler Well No. 2
Office Address. 705 Fourth National Bank Bldg., Wichita 2, Kansas
Character of Well (completed as Oil, Gas or Dry Hole). Dry & Abandoned
Date well completed. December 14 19 46
Application for plugging filed. December 13 19 46
Application for plugging approved. December 13 19 46
Plugging commenced. December 13 19 46
Plugging completed. December 14 19 46
Reason for abandonment of well or producing formation. Dry Hole

If a producing well is abandoned, date of last production. 19
Was permission obtained from the Conservation Division or its agents before plugging was com-
menced? Yes

Name of Conservation Agent who supervised plugging of this well. H. W. Kerr, Great Bend, Kansas
Producing formation. Depth to top. Bottom. Total Depth of Well 3327 Feet
Show depth and thickness of all water, oil and gas formations.

OIL, GAS OR WATER RECORDS

CASING RECORD

Formation	Content	From	To	Size	Put In	Pulled Out
				12 $\frac{1}{2}$	205'	
				5 $\frac{1}{2}$	3327'	1523'

Describe in detail the manner in which the well was plugged, indicating where the mud fluid was placed and the method or methods used in introducing it into the hold. If cement or other plugs were used, state the character of same and depth placed, from. feet to feet for each plug set.

3000 - 2960 Plug and 5 sx cement
2960 - 195 Heavy Mud
195 - 165 Plug and 25 sx cement
165 - 10 Heavy Mud
10 - 0 10 sx cement

16 20 11W
90 10

(If additional description is necessary, use BACK of this sheet)

Correspondence regarding this well should be addressed to. F. G. Holl
Address. 705 Fourth National Bank Bldg., Wichita 2, Kansas

STATE OF Kansas, COUNTY OF Sedgwick, ss.
Thos. H. Allen

(employee or owner) or (owner or operator) of the above-described well,
being first duly sworn on oath, says: That I have knowledge of the facts, statements, and matters herein contained and the log of the above-
described well as filed and that the same are true and correct. So help me God.

HOLL AND HENDERSON
(Signature) By Thos. H. Allen
92100 Union Nat'l Bank Bldg Wichita
(Address)

SUBSCRIBED AND SWORN to before me this 17th day of December, 19 46

My commission expires. June 14, 1950

21-543-s

8-45-6M

Notary Public.

12-28-46

WELL LOG BUREAU - KANSAS GEOLOGICAL SOCIETY

UNION NATIONAL BANK BLDG WICHITA KANSAS


Location. CNW SE

Sec. 16 T. 20 R. 11W.

Casing Record.

County. Barton.

30" 10" Farm. Peter Scheufler No. 1
 8 1/2" Company Atlantic Oil Producing Co.
 15 1/2" 7" 3329' 7" Contr. Noble Drilling Co.
 22 3/4" 205 53/16" Comm. 9-4-33 Comp. 10-15-33
 Total Depth. 3376 Shot Quarts Between.
 Correspondence Regarding This Well Should Be Referred To.

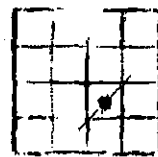

Elevation.


Initial Production. DRY

Figures Indicate Bottom of Formations.

Date Issued. 10-28-33

Formation	Depth	Formation	Depth.
sand and gravel	95	shale blue	3050
shale blue	145	variegated shale	3070
sand	175	broken lime	3077
shale red and sand	200	lime	3216
shell	205	shale blk	3223
red bed	486	lime	3269
anhydrite	517	broken lime and shale	3279
shale and shells	565	shale and lime	3289
red bed and shells	811	lime white	3293
shale and lime shells	970	shale green	3295
salt and shale	1051	chert red	3303
shale and streaks of salt	1340	shale red and chert	3324
shale shells and salt	1420	shale green	3326
anhydrite and lime	1450	shale red and chert	3334
lime grey	1615	chert and lime	3338
broken lime and shale	1676	lime	3376
broken lime	1781	HFV TD.	
lime	1804		
shale and shells	1890	show oil 3130-3145	
broken shale and lime	2020	show oil 3248-3269	
broken lime	2098	Cored from 3279-3329	
shale and lime shells	2184		
broken lime	2273		
shale blue	2339		
lime and shale	2459		
broken lime and shale	2538		
lime	2582		
shale blue	2642		
broken chat and lime	2650		
lime	2853		
lime broken grey	2910		
shale blue and broken lime	2950		

16 20 11W
 90 10

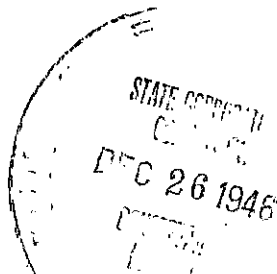

WELL LOG

15.009-14565.0001

Casing
12 1/2" 205
5 1/2" - 3327' - Pulled 1523'

Holl & Henderson #2 Scheufler
C NW $\frac{1}{4}$ SE $\frac{1}{4}$ 16-20-11W
Silica Pool
Barton County, Kansas
Commenced: 11/16/46
Completed: 12/14/46
Contractor: Thos. H. Allan
I. P. Dry & Abandoned

0 - 1606 Cleaned out old hole (Drilled by Atlantic Oil Producing
Company October, 1933) Log attached
1606 - 1636 Milled into old 7" OD Casing
1636 - 3327 Cleaned out old casing
3327 Cemented 5 $\frac{1}{2}$ " 14# casing with 25 sacks
Made Lane Well Radioactivity log
Perforated 3243 - 3292, 68 holes
Treated with 1000 gal. acid
Test - no fluid
Perforated 3226 - 3256, 60 holes
Dumped in 40 gal. J. 1 blanket
Treated with 2000 gal. acid
Test - 46 bbl. water/8 hours
Set Lane Well plug at 3218
Perforated 3129-3158, 106 holes
Treated with 1500 gal. acid
Test - 5 $\frac{1}{2}$ gal. oil & 80 $\frac{1}{2}$ gal. water/1 hour
Plugged & pulled 5 $\frac{1}{2}$ " casing

I certify that the above is a true and
correct copy of the well log on the above test.

Thos. H. Allan
Thos. H. Allan

Subscribed and sworn to before me this 17th
day of December, 1946.

My Commission expires
June 14, 1950.

Oliver M. Stewart
Notary Public

