


Give All Information Completely
Make Required Affidavit
File or Deliver Report to:
Conservation Division
State Corporation Commission
800 Bittling Building
Wichita, Kansas

WELL PLUGGING RECORD

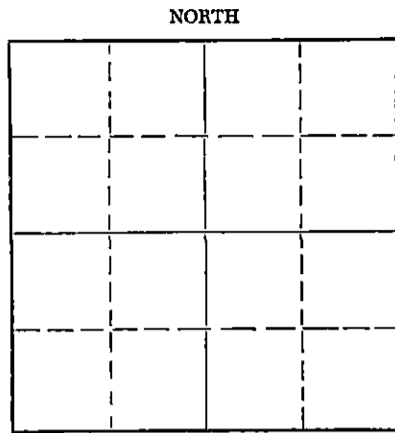

Locate well correctly on above
Section Plot

Rice County. Sec. 22 Twp. 20S Rge. 10W (E) (W)
Location as "NE/CNW/SE/SW" or footage from lines NW NW NE
Lease Owner H. L. Herbel Production Company
Lease Name Steckel Well No. 1
Office Address Chase, Kansas - Box 506
Character of Well (completed as Oil, Gas or Dry Hole) Dry Hole
Date well completed November 2 19 53
Application for plugging filed January 16 19 54
Application for plugging approved January 18 19 54
Plugging commenced January 16 19 54
Plugging completed January 25 19 54
Reason for abandonment of well or producing formation Dry Hole

If a producing well is abandoned, date of last production _____ 19 ____
Was permission obtained from the Conservation Division or its agents before plugging was commenced? Yes

Name of Conservation Agent who supervised plugging of this well Ruell Durkee
Producing formation _____ Depth to top _____ Bottom _____ Total Depth of Well 3397' Feet
Show depth and thickness of all water, oil and gas formations.

OIL, GAS OR WATER RECORDS

CASING RECORD

FORMATION	CONTENT	FROM	TO	SIZE	PUT IN	PULLED OUT
				8-5/8"	155'	None
				5-1/2"	3393'	1561'

Describe in detail the manner in which the well was plugged, indicating where the mud fluid was placed and the method or methods used in introducing it into the hole. If cement or other plugs were used, state the character of same and depth placed, from _____ feet to _____ feet for each plug set.

Filled hole with chat from 3397' to 3385' and ran 6 sacks of cement which filled to 3345'. Mudded hole to 160', set a 10' rock bridge and ran 15 sacks of cement at 150'. Mudded hole to 18' and ran 5 sacks of cement. Plugging completed.

(If additional description is necessary, use BACK of this sheet)
Name of Plugging Contractor West Supply Company 2-6-54
Address Chase, Kansas


STATE OF Kansas COUNTY OF Rice, ss.
E. E. Bruen (employee of owner) or (owner-or-operator) of the above-described well, being first duly sworn on oath, says: That I have knowledge of the facts, statements, and matters herein contained and the log of the above-described well as filed and that the same are true and correct. So help me God.

(Signature) E. E. Bruen
Chase, Kansas (Address)

SUBSCRIBED AND SWORN TO before me this 5th day of February, 19 54

My commission expires May 20, 1957

Edward E. Bruen
Notary Public.

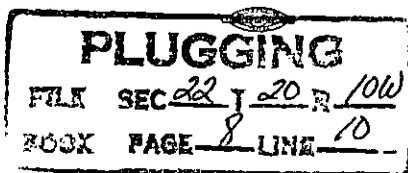

DRILLERS LOG

COMPANY: H. L. HERBEL
 FARM: STECKEL WELL NO. 1

SEC. 22 T. 20S R. 10W
 LOC. NW NW NE
 RICE COUNTY, KANSAS

TOTAL DEPTH: 3394'
 COMM: 10-24-53 COMP: 11-2-53
 CONTRACTOR: HONAKER DRILLING COMPANY

ELEVATION: 1832' DF

CASING
 8 5/8" 155'
 5 1/2" 3393'

0	5	Top Soil	
5	50	Sand and Clay	
50	125	Sand and Gravel	
125	380	Blue Shale	8 5/8" Casing Cemented at
380	570	Red Bed and Shells	155' with 100 Sacks Cement
570	680	Red Bed and Shale	and 2 Sacks Calcium Chloride
680	700	Anhydrite	
700	1180	Shale and Shells	
1180	1255	Salt and Shells	
1255	1325	Shale and Shells	
1325	2000	Lime and Shale	
2000	2395	Shale	
2395	2460	Lime and Shale	
2460	2540	Shale and Shells	
2540	3268	Lime and Shale	
3268	3394	Lime	
3394		Total Rotary Depth	5 1/2" Casing Cemented at
			3393' with 75 Sacks Cement

I certify that this is the true and correct copy of the above log, to the best of my knowledge.

Joe J. Honaker

Subscribed and sworn to before me this 6 day of November 1953.

Joseph P. ...

 Notary Public.

My Commission Expires 6-25-55

PLUGGING
 FILE SEC 22 T 20 R 10W
