


STATE OF KANSAS  
STATE CORPORATION COMMISSION

Give All Information Completely  
Make Required Affidavit  
Mail or Deliver Report to  
Conservation Division  
State Corporation Commission  
245 North Water  
Wichita, KS 67202

FORM CP-4

WELL PLUGGING RECORD

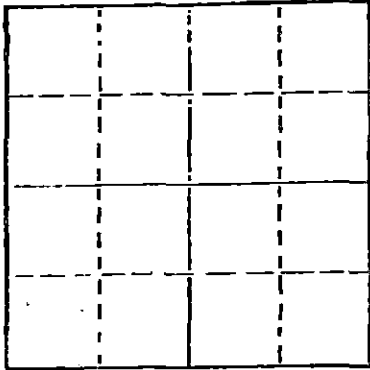

Locate well correctly on above  
Section Plat

Rice County, Sec. 22 Twp. 20 Rge. 10 (E) (W)  
Location as "NE/CNW/SW2" or footage from lines SE SW NW  
Lease Owner Mapco, Inc.  
Lease Name Kelly #1 Well No.  
Office Address Tulsa, Oklahoma  
Character of Well (completed as Oil, Gas or Dry Hole)  
Date well completed 19  
Application for plugging filed 19  
Application for plugging approved 19  
Plugging commenced 7/26/76 19  
Plugging completed 8/4/76 19  
Reason for abandonment of well or producing formation depleted.  
If a producing well is abandoned, date of last production 19  
Was permission obtained from the Conservation Division or its agents before plugging was commenced? YES

Name of Conservation Agent who supervised plugging of this well Tomari  
Producing formation Depth to top Bottom Total Depth of Well 2660 Feet  
Show depth and thickness of all water, oil and gas formations.

OIL, GAS OR WATER RECORDS

CASING RECORD

FORMATION	CONTENT	FROM	TO	SIZE	PUT IN	PULLED OUT
				8-5/8	255	none
				5 1/2"	2665	1786'

Describe in detail the manner in which the well was plugged, indicating where the mud fluid was placed and the method or methods used in introducing it into the hole. If cement or other plugs were used, state the character of same and depth placed, from feet to feet for each plug set.

Pushed plug to 2300' and ran 15' of sand on plug and 5 sacks cement.  
Shot pipe at 1793', pulled pipe. Pumped 3 sacks hulls, 20 sacks gel  
and 85 sacks cement.

RECEIVED  
STATE CORPORATION COMMISSION

PLUGGING COMPLETE.

SEP 01 1976

CONSERVATION DIVISION  
Wichita, Kansas

Name of Plugging Contractor VOTH CASING PULLING  
Address CHASE, KANSAS

STATE OF KANSAS COUNTY OF RICE  
WALTER VOTH (employee of owner) or (owner or operator) of the above-described

well, being first duly sworn on oath, says: That I have knowledge of the facts, statements, and matters herein contained and the log of the above-described well as filed and that the same are true and correct. So help me God.

(Signature) Walter Voth  
CHASE, KANSAS

Subscribed and sworn to before me this 18th day of August 1976

My commission expires  
NOTARY PUBLIC  
MARGARET MELCHER  
Rice County, Ks.  
My Comm. Exp. Feb. 15, 1979

Margaret Melcher  
Notary Public.