


WELL PLUGGING RECORD

Give All Information Completely
Make Required Affidavit
Mail or Deliver Report to:
Conservation Division
State Corporation Commission
212 North Market, Insurance Bldg.
Wichita, Kansas

County. Sec. 7 Twp. 20 Rge. 11 (E) (W)
Location as "NE/CNW%SW%" or footage from lines 120' South of SE NW SW
Lease Owner Bea Drilling Company
Lease Name Koch Well No. 1
Office Address Box 206, Ellinwood, Kansas
Character of Well (completed as Oil, Gas or Dry Hole) _____
Date well completed _____ 19____
Application for plugging filed 1-27-60 19____
Application for plugging approved 1-27-60 19____
Plugging commenced 1-27-60 19____
Plugging completed 1-27-60 19____
Reason for abandonment of well or producing formation Production too low.

NORTH

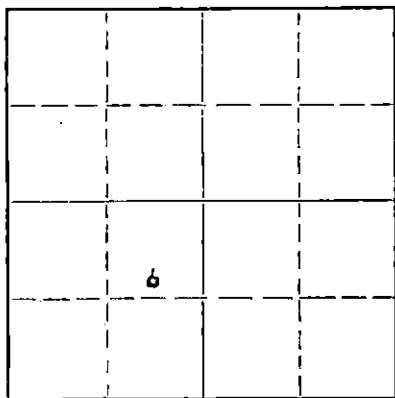

Locate well correctly on above Section Plat

If a producing well is abandoned, date of last production December 19 59
Was permission obtained from the Conservation Division or its agents before plugging was commenced? Yes

Name of Conservation Agent who supervised plugging of this well Donal Truan
Producing formation Arbuckle Depth to top _____ Bottom _____ Total Depth of Well 3347 Feet
Show depth and thickness of all water, oil and gas formations.

OIL, GAS OR WATER RECORDS

CASING RECORD

FORMATION	CONTENT	FROM	TO	SIZE	PUT IN	PULLED OUT

Describe in detail the manner in which the well was plugged, indicating where the mud fluid was placed and the method or methods used in introducing it into the hole. If cement or other plugs were used, state the character of same and depth placed, from _____ feet to _____ feet for each plug set.

Mudded from 3290' to 200' rock bridge from 200' to 190' and run 10 sacks.
Bailed down water and oil. Run 15 sacks of cement from 190' to 125'. Mudded
from 125' to 30' and ran 10 sacks cement to base of cellar.

RECEIVED
STATE CORPORATION COMMISSION
FEB 18 1960

2-18-60

(If additional description is necessary, use BACK of this sheet)
Name of Plugging Contractor Glenn & Smith Pipe Pulling Company Permit # 396
Address Box 114, Ellinwood, Kansas

STATE OF Kansas, COUNTY OF Barton, ss.
B. E. Ash (employee of owner) or (owner or operator) of the above-described well, being first duly sworn on oath, says: That I have knowledge of the facts, statements, and matters herein contained and the log of the above-described well as filed and that the same are true and correct. So help me God.

(Signature) B E Ash

SUBSCRIBED AND SWORN TO before me this 17 day of February, 19 60
Thelma R. Ash (Address)

My commission expires November 15, 1962 Notary Public.

B. E. ASH ET AL

Mina Koch "C" 1
SE-NW-SW Sec. 7-20-11
Barton County, Ks.

Comm. Rig up :	10-13-54	Elevation RB :	1758
Comm. Drig. :	10-14-54	Initial Prod. :	40 Bbls. Est.
Comp. RD :	10-25-54	Contractor :	BEA Drig. Co.
Completed :	11- 2-54	Tools :	Rotary
Total Depth :	3334'		

CASING RECORD

240'	<u>Run</u> 8-5/8" Surface Casing cemented with 150 sacks	<u>Pulled</u>	204'	<u>Left in</u> 8-5/8" Casing
3330'	5-1/2" OD 17# lapweld Casing cemented with 75 sacks		3330'	5-1/2" Casing

STRATA	DEPTH	FORMATION TDPS R.B.
Sand	90	Topeka Lime 2751 (-963)
Shale	105	Heebner Shale 2961 (-1173)
Shale & Shells	245	Toronto Lime 2988 (-1200)
Red Bed & Shale	350	Base Ord Lime 2995 (-1207)
Anhydrite	570	Brown Lime 3079 (-1291)
Shale & Shells	1050	KC or Lansing 3098 (-1310)
Salt & Shale	1305	No Conglomerate
Shale & Shells	1475	Arbuckle 3327 1/2 (-1539 1/2)
Lime	1845	
Lime & Shale	2725	Show Oil KC or Lansing Lime 3102 -- 3106
Lime	2940	Show Oil KC or Lansing Lime 3114 -- 3120
Lime & Shale	3130	DST 3100-3130 open 45 minutes, weak blow for
Lime	3334	15 minutes and diod. Recovered 30" Rotary
Total Depth	3334	mud. BHP "0".

Show Oil Arbuckle Lime 3327 1/2--3334
completed in Arbuckle Lime 3330-3334 made
approximately 3/4 Bbls. oil & trace of water
per hour natural. Acidified with 250 Bbls. acid
swabbed 2 Bbls. oil & trace of water per hour,
no increase in water.

RECEIVED
STATE CORPORATION COMMISSION

FEB 18 1954

CONSERVATION DEPARTMENT
Wichita, Kas.

I hereby certify that the above is a true and correct log of said well
as reflected by the daily drilling reports.

B. E. Ash
B. E. Ash

STATE OF KANSAS, COUNTY OF MIDGWICK, SS:

Subscribed and sworn to before me this 4th day of November, 1954

Thelma L. Ash
Notary Public

My commission expires November 15, 1962