


WELL PLUGGING RECORD

Give All Information Completely
Make Required Affidavit
Mail or Deliver Report to:
Conservation Division
State Corporation Commission
800 Bitting Building
Wichita, Kansas

Barton County. Sec. 7 Twp. 20S Rge. 11W (E) -(W)
Location as "NE/CNW/SW" or footage from lines C.E.L. NE SW
Lease Owner Morris Mizel - Harry Miller
Lease Name Schartz Well No. 4
Office Address 905 Kennedy Bldg., Tulsa, Oklahoma
Character of Well (completed as Oil, Gas or Dry Hole) Oil
Date well completed 6-3 19 42
Application for plugging filed 19
Application for plugging approved 19
Plugging commenced July 15 19 55
Plugging completed July 20 19 55
Reason for abandonment of well or producing formation

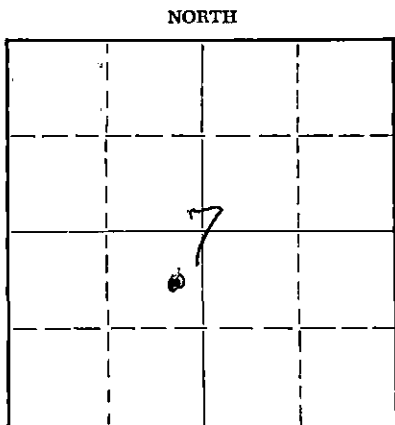

Locate well correctly on above Section Plat

If a producing well is abandoned, date of last production 7-5 19 55
Was permission obtained from the Conservation Division or its agents before plugging was commenced? Yes
Name of Conservation Agent who supervised plugging of this well Warren Horner

Producing formation Arbuckle Depth to top 3313' Bottom 3321' Total Depth of Well 3321' Feet
Show depth and thickness of all water, oil and gas formations.

OIL, GAS OR WATER RECORDS

CASING RECORD

FORMATION	CONTENT	FROM	TO	SIZE	PUT IN	PULLED OUT
				8-5/8" OD	310'	None
Arbuckle	Oil	3313'	3321'	5-1/2" OD	3309'	2868'

Describe in detail the manner in which the well was plugged, indicating where the mud fluid was placed and the method or methods used in introducing it into the hole. If cement or other plugs were used, state the character of same and depth placed, from feet to feet for each plug set.

Filled hole with sand to 3330'. Dumped 5 sacks of cement at 3330'. Shot pipe off at 286'. Pulled pipe and pumped 20 sacks of mud and 100 sacks of cement in hole with Halliburton.

RECEIVED
STATE CORPORATION COMMISSION
AUG 4 1955
CONSERVATION DIVISION
Wichita, Kansas

Name of Plugging Contractor Bert Self
Address RR #4 - Hutchinson, Kansas

STATE OF Kans. COUNTY OF Reno, ss.
Employee (employee of owner) or (owner or operator) of the above-described

well, being first duly sworn on oath, says: That I have knowledge of the facts, statements, and matters herein contained and the log of the above-described well as filed and that the same are true and correct. So help me God.

(Signature) Bert Self
RR # 4, Hutchinson, Kans.
(Address)

SUBSCRIBED AND SWORN TO before me this 25th day of July, 19 55

My commission expires August 12, 1957
Warren Horner Notary Public.

PLUGGING
FILE SEC 7 T20 R 11W
BOOK PAGE 136 LINE 34

C. E. ASH ET AL
 P. Schartz B #4
 CEL NE SW $\frac{1}{4}$ Sec. 7-20-11W.
 Barton County, Kansas

Comm. Rig Up : 4-11-1942 Elevation :
 Comm. Drlg. : 4-12-1942 Initial Prod. : 56 bbls. Temp.
 Completed : 6- 3-1942 Contractor : Comet Drlg. Co.
 Total Depth : 3321' Tools : Rotary

CASING RECORD	
Run	Left In
310' 8-5/8" Surface	310' 8-5/8" Surface
3309' 5-1/2" Cemented	3309' 5-1/2"

STRATA	DEPTH
Surface Clay	10
Sand	75
Shale, Shells & Sand	245
Shale & Shells	311
Red Bed	535
Anhydrate Lime	556
Shale & Shells	1020
Salt	1320
Shale & Shells	1524
Lime	1845
Shale	1855
Lime & Shale Breaks	2180
Shale	2200
Lime	2227
Lime with Shale Breaks	2323
Shale & Shells	2435
Lime & Shale Breaks	2500
Lime	2605
Shale & Shells	2674
Lime	2690
Shale	2695
Lime	2970
Shale	2975
Lime	3005
Shale & Shells	3016
Lime	3022
Shale	3065
Lime	3071
Shale & Shells	3080
K.C. Lime	3313
Sil. Lime	3321
Total Depth	3321

RECEIVED
 OIL & GAS CORPORATION COMMISSION
 JUN 11 1942
 CONSERVATION DIVISION
 Wichita, Kansas

I hereby certify that the above is the true and correct log of said well as reflected by the daily drilling reports.

Manager, Comet Drlg. Co.

Subscribed in my presence and sworn to before me this 6th day of June, 1942.

Notary Public in and for Sedgwick County, Kansas.

My commission expires April 15, 1946.

PLUGGING
 FILE SEC 7 T20 R 11W
 BOOK 136 LINE 34