

STATE OF KANSAS
STATE CORPORATION COMMISSION

WELL PLUGGING RECORD

OR
FORMATION PLUGGING RECORD

Strike out upper line
when reporting plug-
ging off formations.

Give All Information Completely
Make Required Report
Mail or Deliver Report to:
Conservation Division
State Corporation Commission
800 Bitting Building
Wichita, Kansas

Barton County. Sec. 1 Twp. 20 Rge. 11 ~~E~~ ~~W~~ (W)

Location as "NE 1/4 NW 1/4 SW 1/4" or footage from lines. NE SW SE

Lease Owner. Courtney B. Davis, Inc.,

Lease Name. Steckel Well No. 10

Office Address. 521 Union National Bank Bldg., Wichita, Kansas

Character of Well (completed as Oil, Gas or Dry Hole). Abandoned Oil Well

Date well completed. July 13, 1937

Application for plugging filed. March 21, 1947

Application for plugging approved. April 8, 1947


Plugging commenced. April 4, 1947

Plugging completed. April 4, 1947

Reason for abandonment of well or producing formation. Oil depleted

If a producing well is abandoned, date of last production. 19

Was permission obtained from the Conservation Division or its agents before plugging was com-
menced? Yes

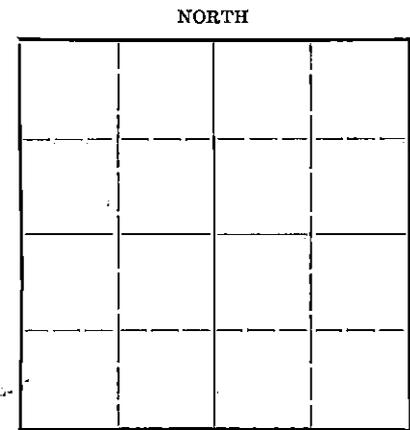

Locate well correctly on above
Section Plat

Name of Conservation Agent who supervised plugging of this well. H. W. Kerr

Producing formation. Depth to top. Bottom. Total Depth of Well. 3267 Feet

Show depth and thickness of all water, oil and gas formations.


OIL, GAS OR WATER RECORDS

CASING RECORD

Formation	Content	From	To	Size	Put In	Pulled Out

Describe in detail the manner in which the well was plugged, indicating where the mud fluid was placed and the method or methods used in introducing it into the hold. If cement or other plugs were used, state the character of same and depth placed, from feet to feet for each plug set.

The hole was plugged Lane plugs and cement from 3267 feet to 3190 feet. Rock from 3190 feet to 3080 feet. Cement from 3080 feet to 3050 feet, with 5 sacks cement. Mud from 3050 feet to 68 feet. Cement from 68 feet to 45 feet with 20 sacks. Mud from 45 feet to 10 feet and cement into base of cellar with 10 sacks.

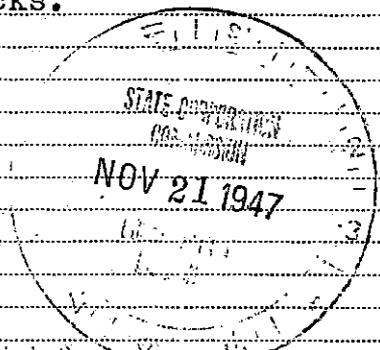

(If additional description is necessary, use BACK of this sheet)

Correspondence regarding this well should be addressed to Courtney B. Davis,
Address. 521 Union National Bank Bldg.,
Wichita, Kansas

STATE OF _____, COUNTY OF _____, ss.


_____ (employee of owner) or (owner or operator) of the above-described well, being first duly sworn on oath, says: That I have knowledge of the facts, statements, and matters herein contained and the log of the above-described well as filed and that the same are true and correct. So help me God.

(Signature) Courtney Davis

(Address)

SUBSCRIBED AND SWORN TO before me this 22 day of November, 1947

My commission expires November 5, 1951 J.P. Roberts Notary Public.

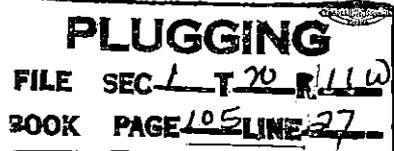


COURTNEY B. DAVIS.
 Stocked No. 10

SEC. 1 T. 20 R. 11W.
 NE SW SE

Total Depth. 3267
 Comm. 6-20-37 Comp. 7-13-37
 Shot or Treated.
 Contractor, Rose Spring Drlg.
 Issued, 8-21-37

County Barton.

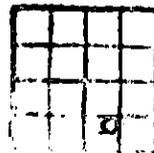

Elevation.

CASING.


12 $\frac{1}{2}$ " 68' 7" 3260'

Production, Pot. 911 B. Nat.
 No wtr.

Figures Indicate Bottom of Formations.

surface	20
sand	60
clay and sand rock	70
sdv lime & pyrite	73
shale and red rock	840
shale and lime shells	860
shale and salt	1250
shale	1280
lime and shale	1340
lime and shale breaks	1445
lime and shale	1690
broken lime	1800
lime and shale	2205
shale and lime shells	2280
shale and lime	2535
shale and shells	2620
broken lime	2660
lime and shale	2705
lime	2760
limo and shale	2790
limo	2855
limo and shale	2900
limo	2935
shalo	3070
broken limo	3135
limo and shale	3175
broken limo	3210
limo and shalo	3261
Top of lime 3260-	3261
limo	3267

Total Depth.

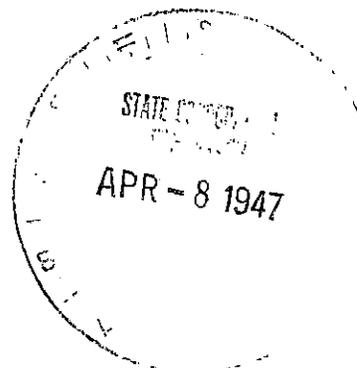

PLUGGING
 FILE SEC. 1 T. 20 R. 11W.
