15-009-14268-0000

STATE OF KANSAS
STATE CORPORATION COMMISSION

Give All Information Completely
Make Required Affidavit
Mail or Deliver Report to:
Conservation Division
State Corporation Commission
800 Bitting Building
Wichita, Kansas

WELL PLUGGING RECORD
OR
FORMATION PLUGGING RECORD

Strike out upper line when reporting plugging off formations.

NORTH

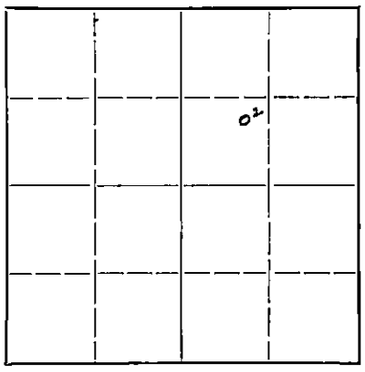

Locate well correctly on above Section Plat

Barton County. Sec. 1 Twp. 20S Rge. 11 ~~(E)~~ (W)

Location as "NE¼NW¼SW¼" or footage from lines NE SW NE

Lease Owner Magnolia Petroleum Company

Lease Name Fred Steckel Well No. 2

Office Address Box 770 - Great Bend, Kansas

Character of Well (completed as Oil, Gas or Dry Hole) Oil

Date well completed December 1935 19

Application for plugging filed March 28, 1950 19

Application for plugging approved March 29, 1950 19

Plugging commenced April 7, 1950 19

Plugging completed April 15, 1950 19

Reason for abandonment of well or producing formation Well temporarily abandoned; did not produce enough to pay to operate

If a producing well is abandoned, date of last production January 1948 19

Was permission obtained from the Conservation Division or its agents before plugging was commenced? Yes

Name of Conservation Agent who supervised plugging of this well C. D. Stough, Great Bend, Kansas

Producing formation Arbuckle Depth to top 3275 Bottom 3289 Total Depth of Well 3289 Feet

Show depth and thickness of all water, oil and gas formations.

OIL, GAS OR WATER RECORDS — CASING RECORD

Formation	Content	From	To	Size	Put In	Pulled Out
Arbuckle	oil	3275	3289	12-1/2"	202	None
				7"	3275	1529' 2"

Describe in detail the manner in which the well was plugged, indicating where the mud fluid was placed and the method or methods used in introducing it into the hold. If cement or other plugs were used, state the character of same and depth placed, from ..... feet to ..... feet for each plug set.

Plugged bottom of hole w/118' river gravel & 12 sax cement; shot & pulled 1529' of 7" Csg; filled hole w/heavy mud to 202'; set bridge @ 202' & cemented w/25 sax cement; filled w/mud & cemented base of cellar w/10 sax cement.

(If additional description is necessary, use BACK of this sheet)

Correspondence regarding this well should be addressed to Mr. C. A. Hill, Magnolia Petroleum Company

Address Box 770 - Great Bend, Kansas

STATE OF KANSAS, COUNTY OF BARTON, ss.

C. A. Hill (employee of owner) or ~~(owner or operator)~~ of the above-described well, being first duly sworn on oath, says: That I have knowledge of the facts, statements, and matters herein contained and the log of the above-described well as filed and that the same are true and correct. So help me God.

(Signature) C. A. Hill

Box 770 - Great Bend, Kansas
(Address)

SUBSCRIBED AND SWORN TO before me this 20th day of April, 1950

Fay Richardson
Notary Public.

My commission expires Oct. 15, 1953

22-237 7-47—10M

APR 21 1950 4-21-50

PLUGGING
FILE SEC. 1 T. 20 R. 11W
BOOK PAGE 145 LINE 9