


WELL PLUGGING RECORD

Give All Information Completely  
Make Required Affidavit  
Mail or Deliver Report to:  
Conservation Division  
State Corporation Commission  
211 No. Broadway  
Wichita, Kansas

Barton County. Sec. 1 Twp. 20S Rge. 11W (E) (W)  
Location as "NE/CNW%SW%" or footage from lines NW NW NE  
Lease Owner Herman George Kaiser, Oil Producer  
Lease Name Fred Steckel Well No. 6  
Office Address Box 666, Ellinwood, Kansas  
Character of Well (completed as Oil, Gas or Dry Hole) oil  
Date well completed April 7, 1936 19  
Application for plugging filed January, 1964 19  
Application for plugging approved January, 1964 19  
Plugging commenced January 16, 1964 19  
Plugging completed January 22, 1964 19  
Reason for abandonment of well or producing formation Zone depleted

NORTH

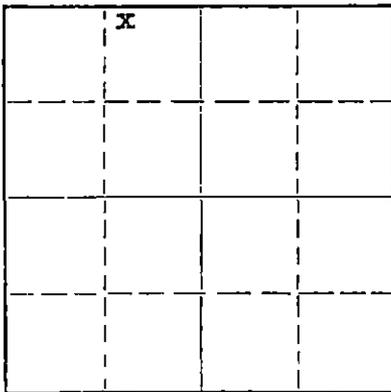

Locate well correctly on above  
Section Plat

If a producing well is abandoned, date of last production October 1, 1963 19 ~~58~~  
Was permission obtained from the Conservation Division or its agents before plugging was commenced? Yes

Name of Conservation Agent who supervised plugging of this well Don Truman  
Producing formation Arbuckle Depth to top 3273 Bottom 3283 Total Depth of Well 3283 Feet  
Show depth and thickness of all water, oil and gas formations.

OIL, GAS OR WATER RECORDS

CASING RECORD

FORMATION	CONTENT	FROM	TO	SIZE	PUT IN	PULLED OUT
Arbuckle	oil	3273	3283	7"	1936	1964

Describe in detail the manner in which the well was plugged, indicating where the mud fluid was placed and the method or methods used in introducing it into the hole. If cement or other plugs were used, state the character of same and depth placed, from \_\_\_\_\_ feet to \_\_\_\_\_ feet for each plug set.

- 1-18-64: Sand back from 3275 1/2' to 3260, dump 5 sacks cement
- 1-21-64: Haul rock and cement, mud to 200', 10' rock bridge, dump 6 sacks cement
- 1-22-64: Dump 39 sacks cement, mud to 40', rock bridge to 20', dump 20 sacks cement

RECEIVED  
STATE CORPORATION COMMISSION

FEB 28 1964

CONSERVATION DIVISION  
Wichita, Kansas

(If additional description is necessary, use BACK of this sheet)

Name of Plugging Contractor Ralph Comstock Pipe Pulling, Inc.  
Address 411 So. Buckeye, Stafford, Kansas

STATE OF Kansas, COUNTY OF Barton, ss.  
Harold F. Yowell (employee of owner) or (owner or operator) of the above-described well, being first duly sworn on oath, says: That I have knowledge of the facts, statements, and matters herein contained and the log of the above-described well as filed and that the same are true and correct. So help me God.

(Signature) Harold F. Yowell  
Ellinwood, Kansas (Address)

SUBSCRIBED AND SWORN TO before me this 27th day of February, 1964

My commission expires Yvonne M. Stevenson, Notary Public  
My Commission Expires August 20, 1967

Notary Public.